



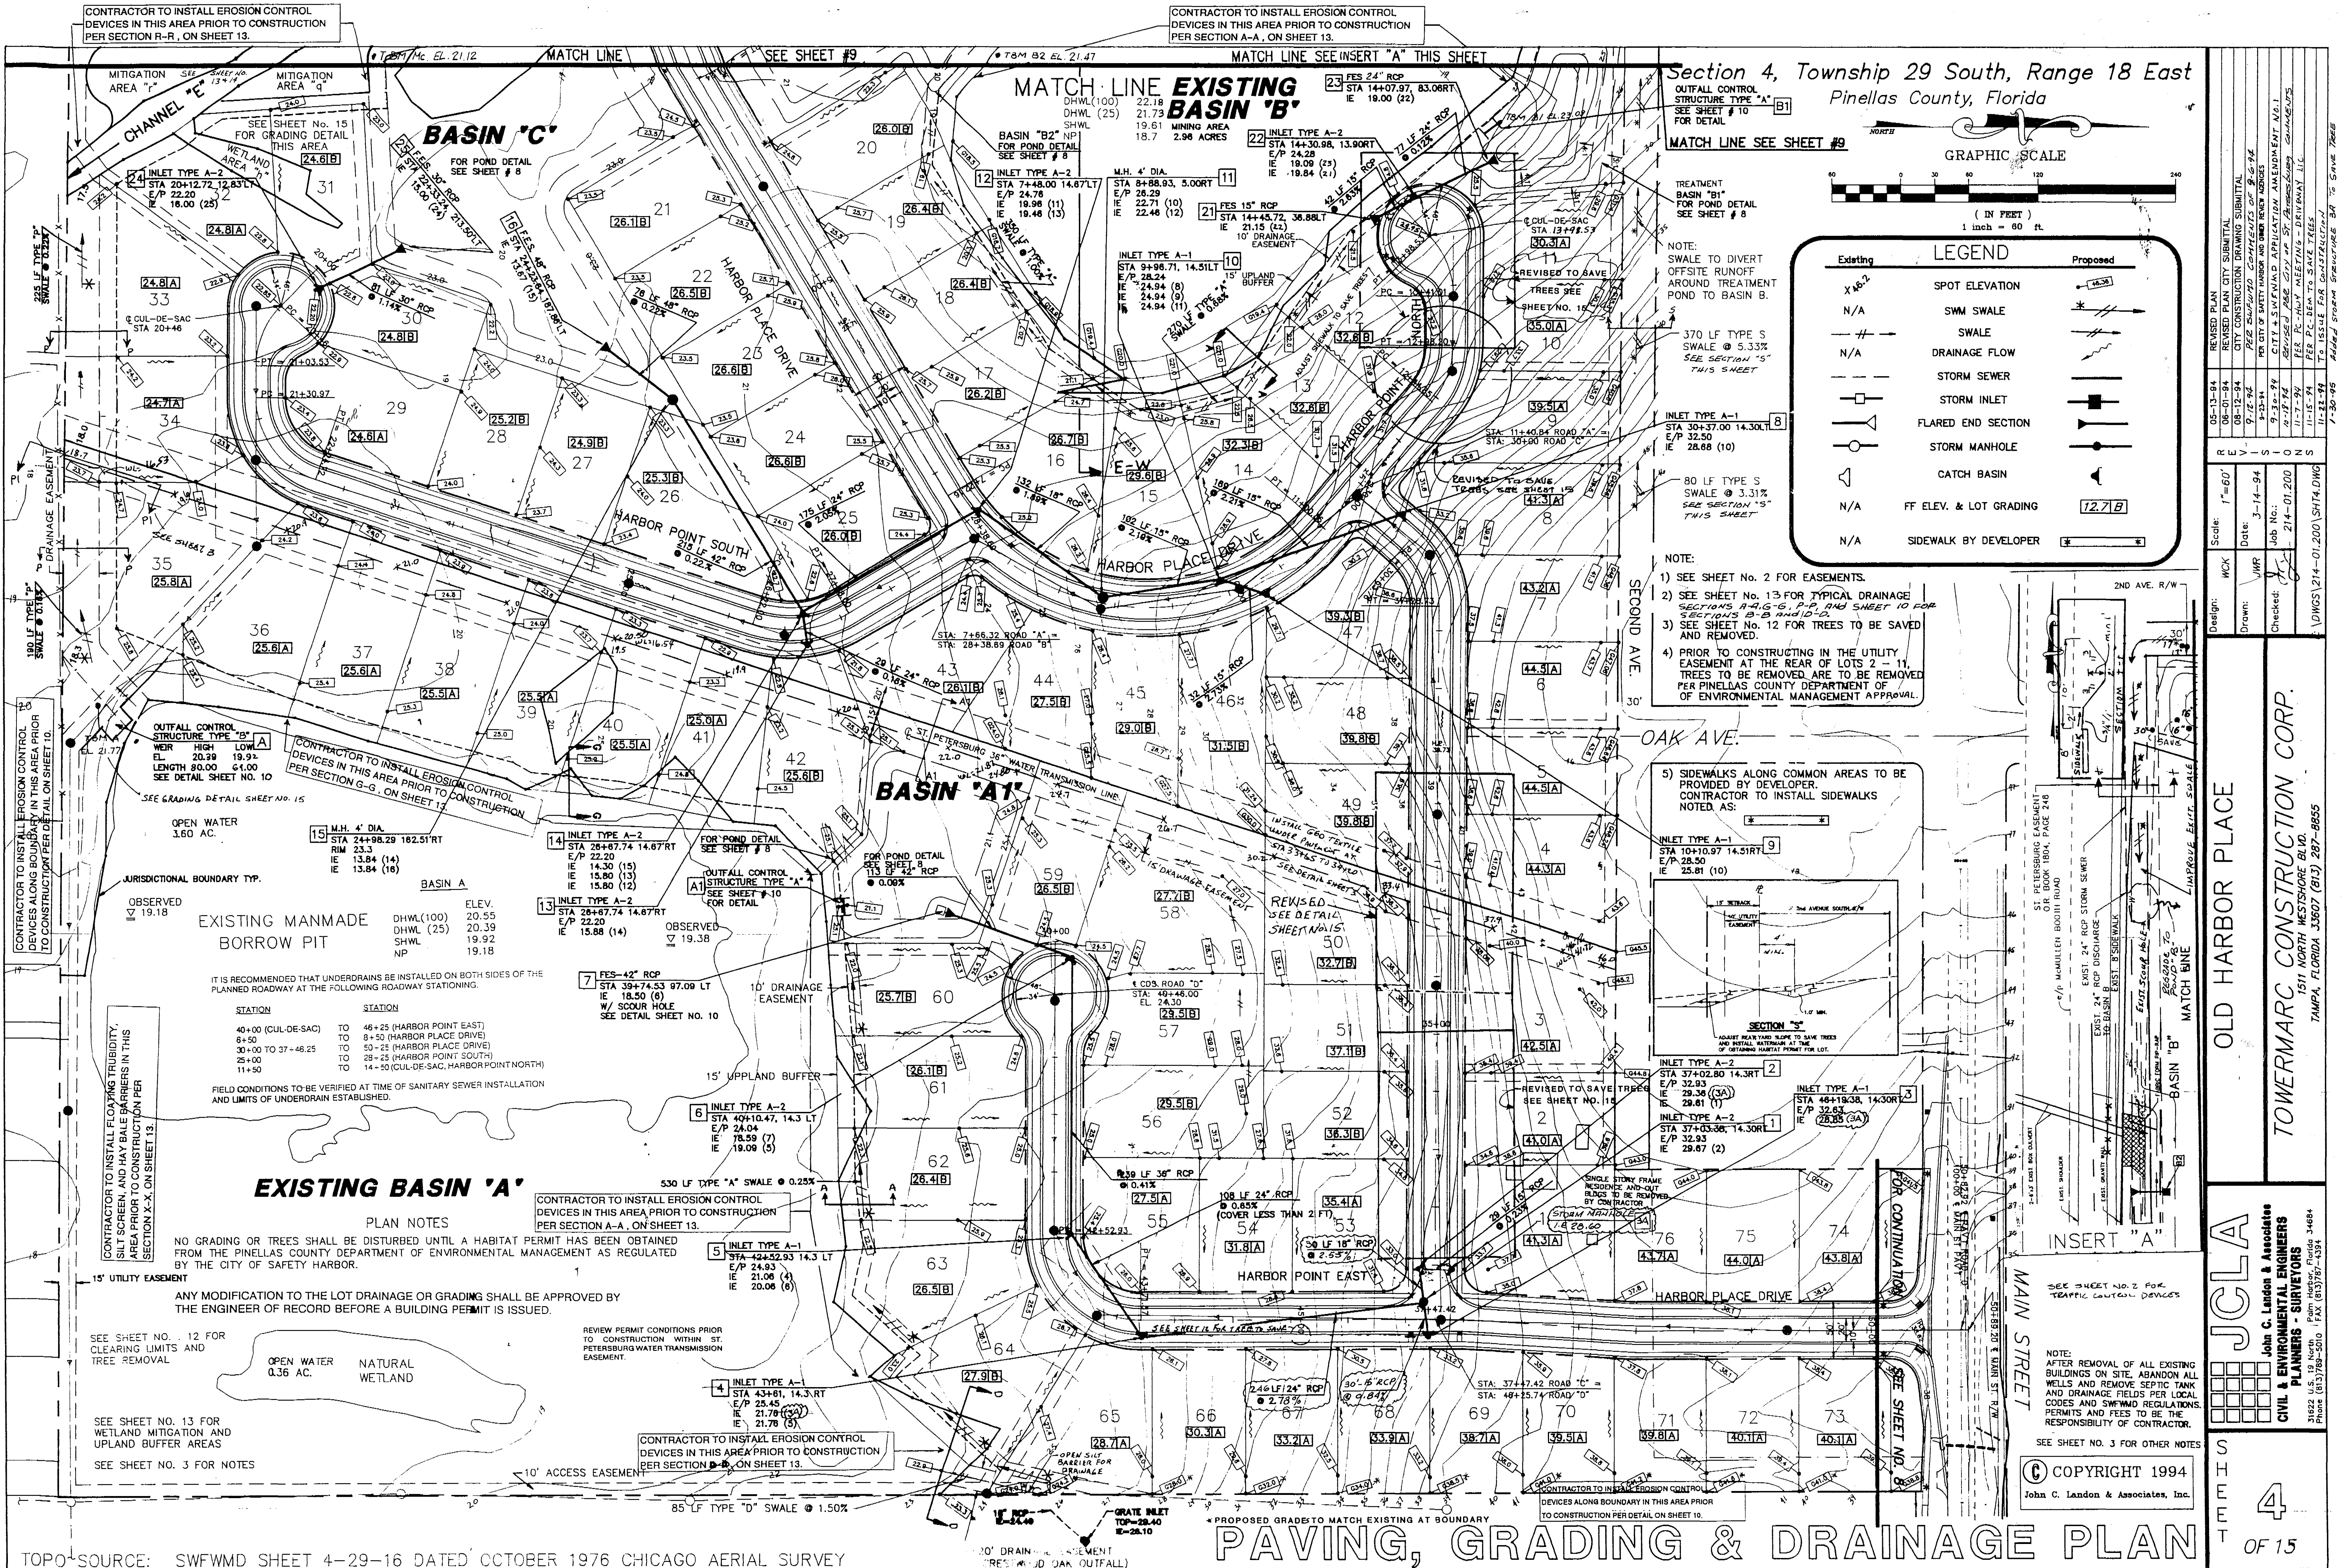


Section 4, Township 29 South, Range 18 East
Pinellas County, Florida

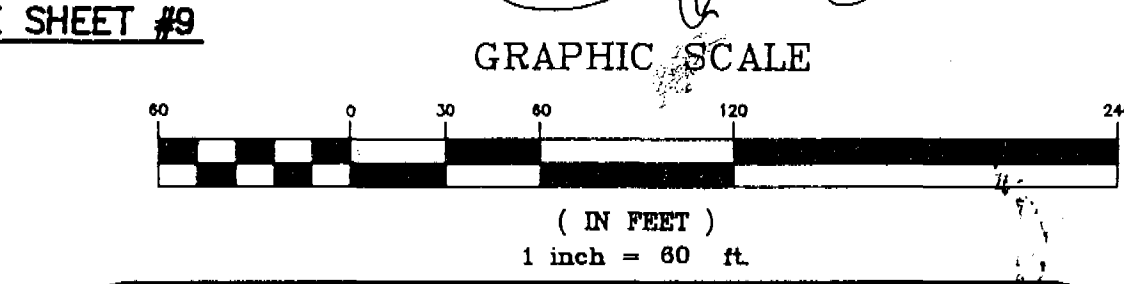

LEGEND	
Existing	Proposed
X 48.2	SPOT ELEVATION
N/A	SWM SWALE
---	SWALE
N/A	DRAINAGE FLOW
---	STORM SEWER
---	STORM INLET
---	FLARED END SECTION
---	STORM MANHOLE
---	CATCH BASIN
N/A	FF ELEV. & LOT GRADING
N/A	SIDEWALK BY DEVELOPER

- NOTE:
- 1) SEE SHEET NO. 2 FOR EASEMENTS.
 - 2) SEE SHEET NO. 13 FOR TYPICAL DRAINAGE SECTIONS A-1-G, P-P, AND SHEET 10 FOR SECTIONS B-B AND D-D.
 - 3) SEE SHEET NO. 12 FOR TREES TO BE SAVED AND REMOVED.
 - 4) PRIOR TO CONSTRUCTING IN THE UTILITY EASEMENT AT THE REAR OF LOTS 2 - 11, TREES TO BE REMOVED ARE TO BE REMOVED PER PINELLAS COUNTY DEPARTMENT OF ENVIRONMENTAL MANAGEMENT APPROVAL.
 - 5) SIDEWALKS ALONG COMMON AREAS TO BE PROVIDED BY DEVELOPER. CONTRACTOR TO INSTALL SIDEWALKS NOTED AS:

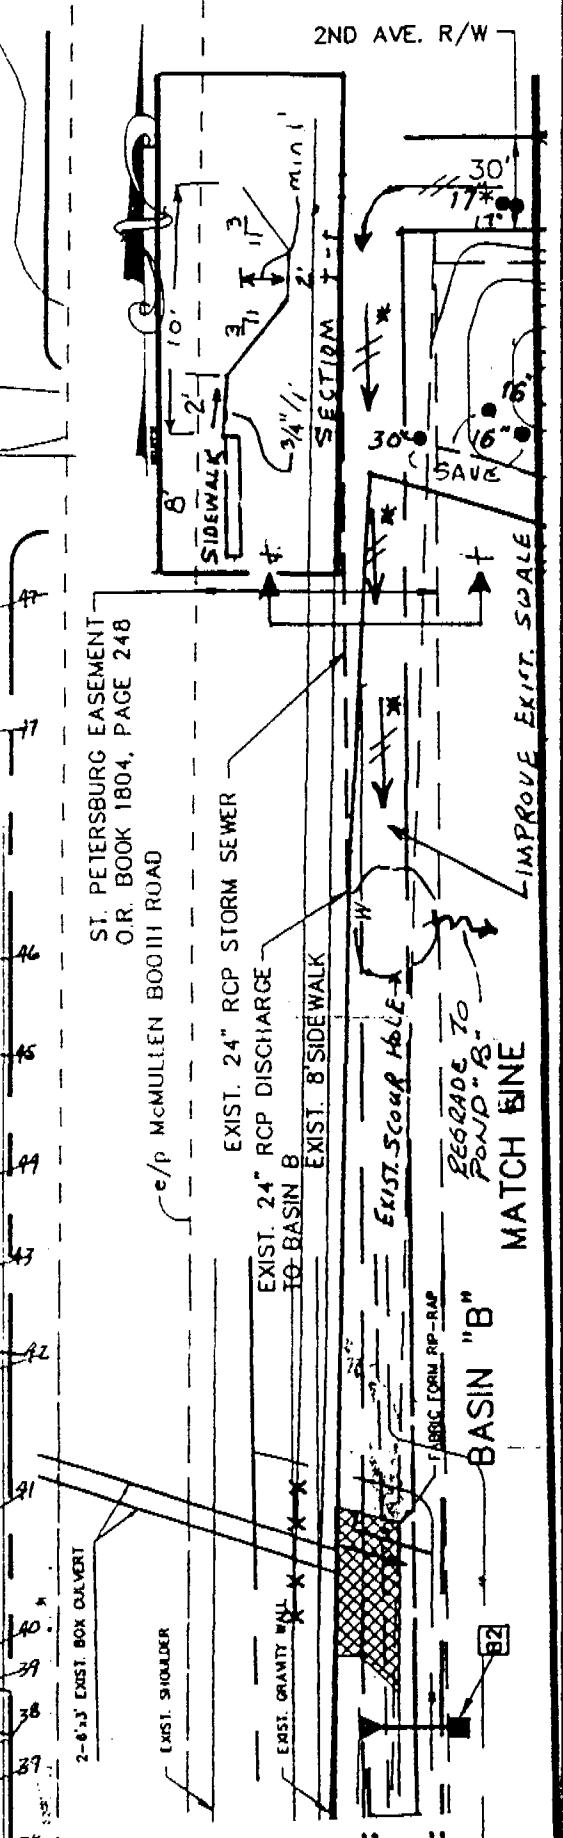

STATION	STATION
40+00 (CUL-DE-SAC)	TO 46+25 (HARBOR POINT EAST)
6+50	TO 8+50 (HARBOR PLACE DRIVE)
30+00 TO 37+48.25	TO 50+25 (HARBOR PLACE DRIVE)
29+00	TO 28+25 (HARBOR POINT SOUTH)
11+50	TO 14+50 (CUL-DE-SAC, HARBOR POINT NORTH)

FIELD CONDITIONS TO BE VERIFIED AT TIME OF SANITARY SEWER INSTALLATION AND LIMITS OF UNDERDRAIN ESTABLISHED.

EXISTING BASIN 'A'

PLAN NOTES

NO GRADING OR TREES SHALL BE DISTURBED UNTIL A HABITAT PERMIT HAS BEEN OBTAINED FROM THE PINELLAS COUNTY DEPARTMENT OF ENVIRONMENTAL MANAGEMENT AS REGULATED BY THE CITY OF SAFETY HARBOR.

ANY MODIFICATION TO THE LOT DRAINAGE OR GRADING SHALL BE APPROVED BY THE ENGINEER OF RECORD BEFORE A BUILDING PERMIT IS ISSUED.

REVIEW PERMIT CONDITIONS PRIOR TO CONSTRUCTION WITHIN ST. PETERSBURG WATER TRANSMISSION EASEMENT.

CONTRACTOR TO INSTALL EROSION CONTROL DEVICES IN THIS AREA PRIOR TO CONSTRUCTION PER SECTION A-A, ON SHEET 13.

CONTRACTOR TO INSTALL EROSION CONTROL DEVICES IN THIS AREA PRIOR TO CONSTRUCTION PER SECTION R-R, ON SHEET 13.

CONTRACTOR TO INSTALL EROSION CONTROL DEVICES IN THIS AREA PRIOR TO CONSTRUCTION PER SECTION A-A, ON SHEET 13.

REVISION PLAN CITY SUBMITTAL
CITY CONSTRUCTION DRAWING SUBMITTAL
PER CITY OF SAFETY HARBOR AND OTHER REVIEW AGENCIES
CITY & COUNTY ENGINEER'S APPLICATION AMENDMENT NO. 1
RECEIVED BY CITY OF SAFETY HARBOR
PER CITY OF SAFETY HARBOR
TO ISSUE FOR CONSTRUCTION
1-30-95

Scale: 1"=60'
Date: 3-14-94
Job No.: 214-01-200
DWG: 214-01-200 (SHEET 4 OF 15)

Design: WCK
Drawn: JWP
Checked: JWP

TOWERMARC CONSTRUCTION CORP.
1511 NORTH WESTSHORE BLVD.
TAMPA, FLORIDA 33607 (813) 287-8855

JCLA
John C. Landon & Associates
CIVIL & ENVIRONMENTAL ENGINEERS
PLANNERS - SURVEYORS
31822 US 19, 19th St. N., Suite 200
Pinellas County, Florida 34684
Phone (813) 769-5010 FAX (813) 769-4394