
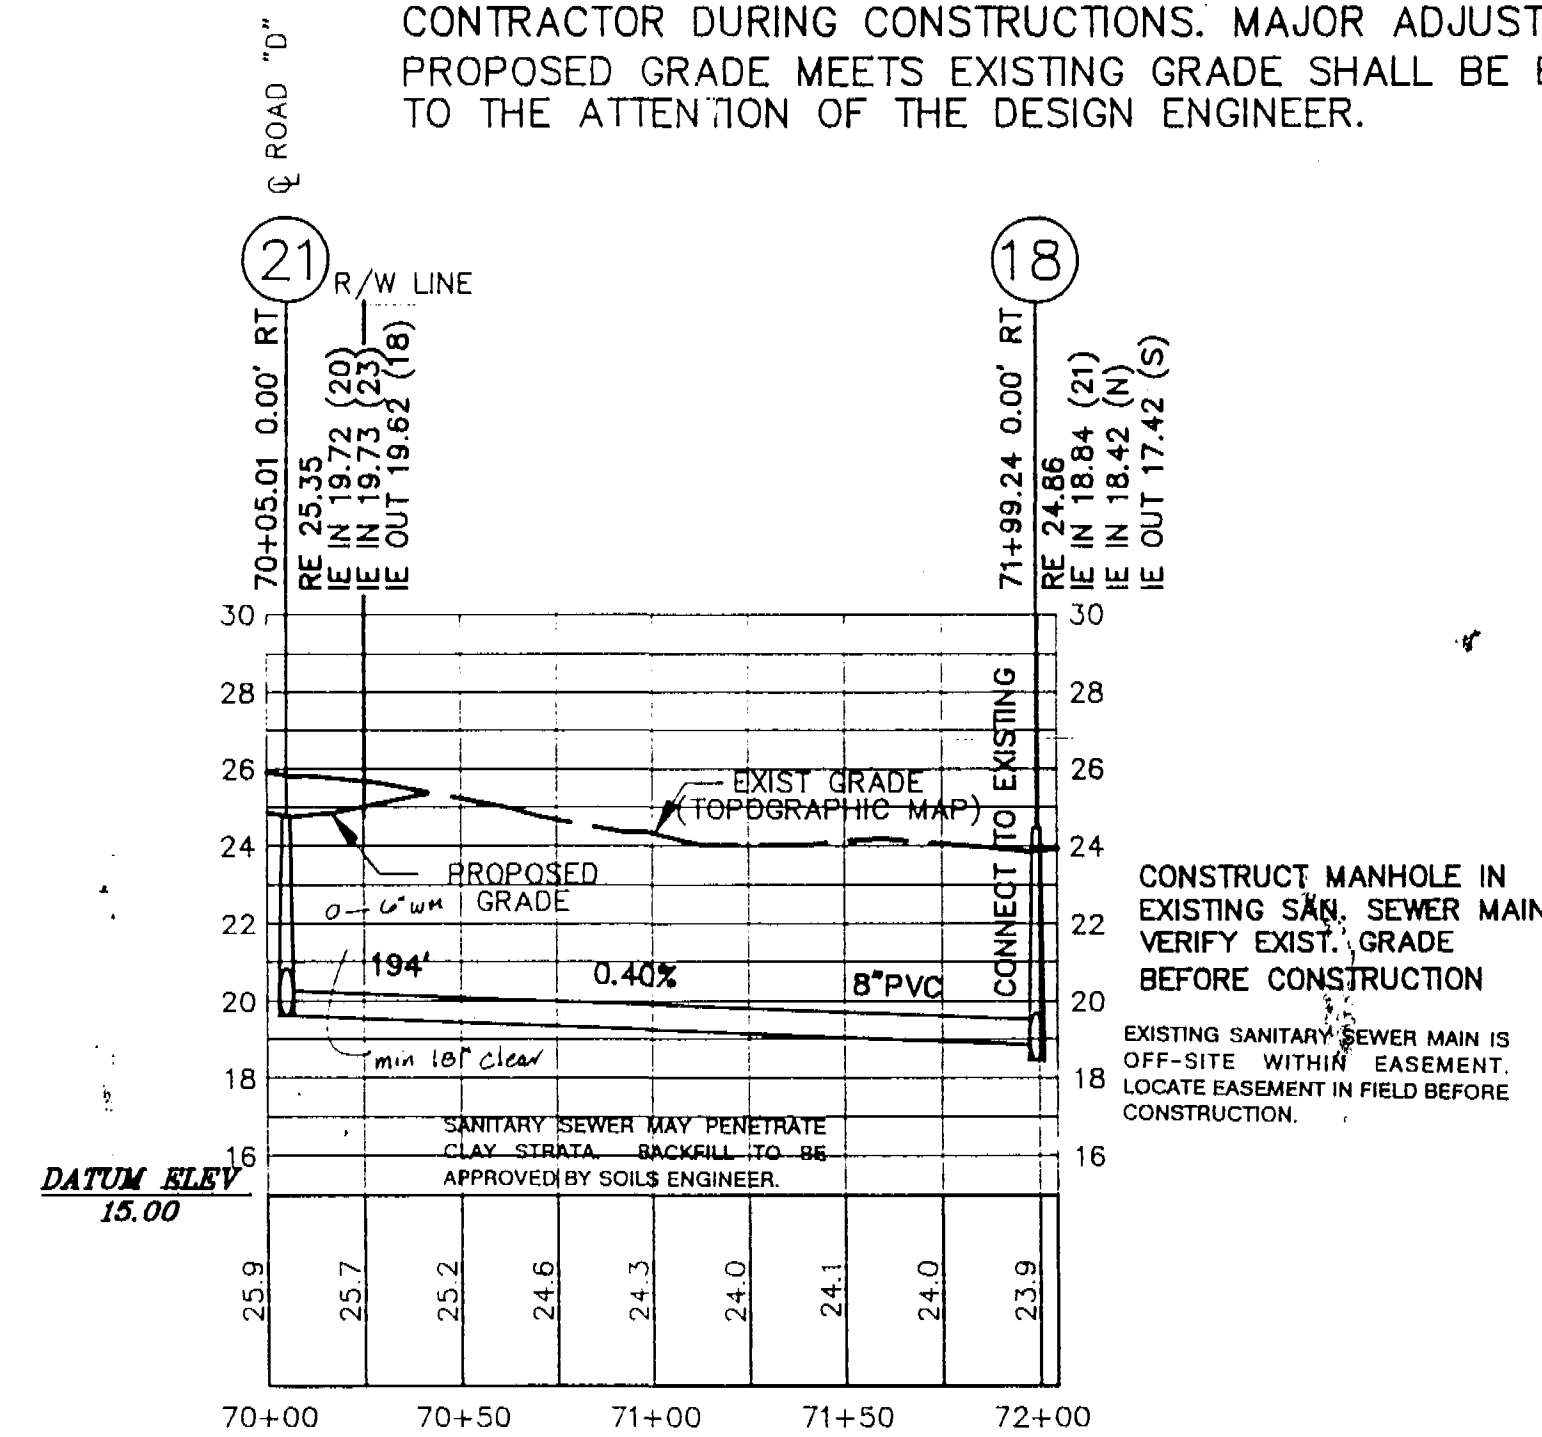


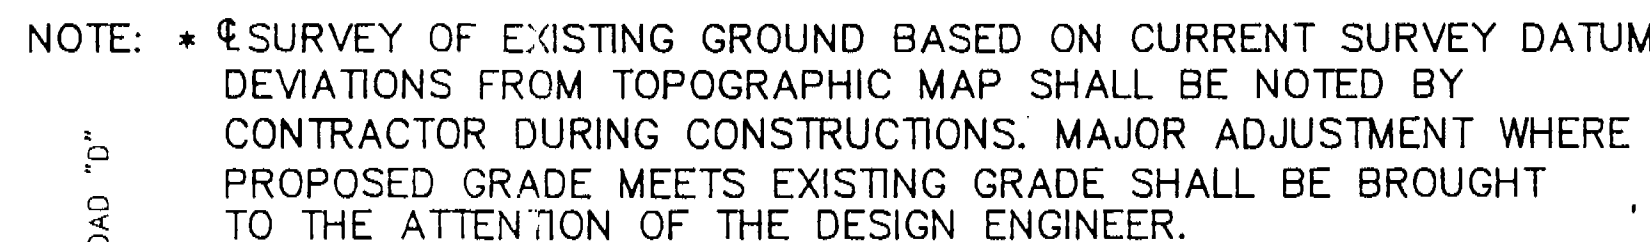

EAST PROP. LINE SAN. SEWER

NOTE: ALL SANITARY SEWER WITH LESS THAN 3'-0" COVER TO BE D.I.P.

SCALE:
1" = 50' HORI
1" = 5' VERT.

PROFILES

5
OF 15

OLD HARBOR PLACE

TOWERMARC CONSTRUCTION CORP.

1511 NORTH WESTSHORE BLVD.
TAMPA, FLORIDA 33607 (813) 287-8855

Design	NCK	Scale	1"=50'
Drawn	JMR	Date	03-14-94
Checked		Job No.	214-01
REVISIONS NO. DATE BY DESCRIPTION 1 08-12-94 CITY CONSTRUCTION DRAWING SUBMITTAL 2 09-27-94 PER CITY OF SAFETY HAZARD AND STREET REVENUE AGENCIES 3 10-26-94 PER CITY OF SAFETY HAZARD AND STREET REVENUE AGENCIES 4 11-08-94 PER U.S. ARMY CORPS OF ENGINEERS 5 11-22-94 PER U.S. ARMY CORPS OF ENGINEERS 6 11-22-94 TO ISSUE FOR CONSTRUCTION			