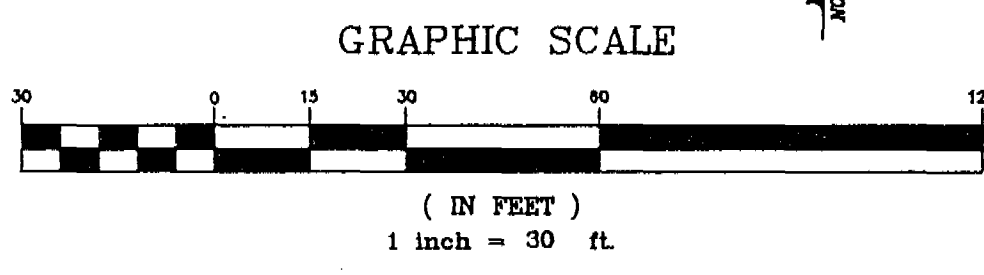


FROM

[illegible]