
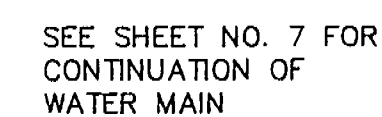


Section 4, Township 29 South, Range 16 East
Pinellas County, Florida //

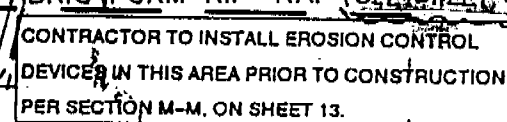

McMULLEN BOOTH ROAD IMPROVEMENTS

S
H
E
E
T
9
OF 15