
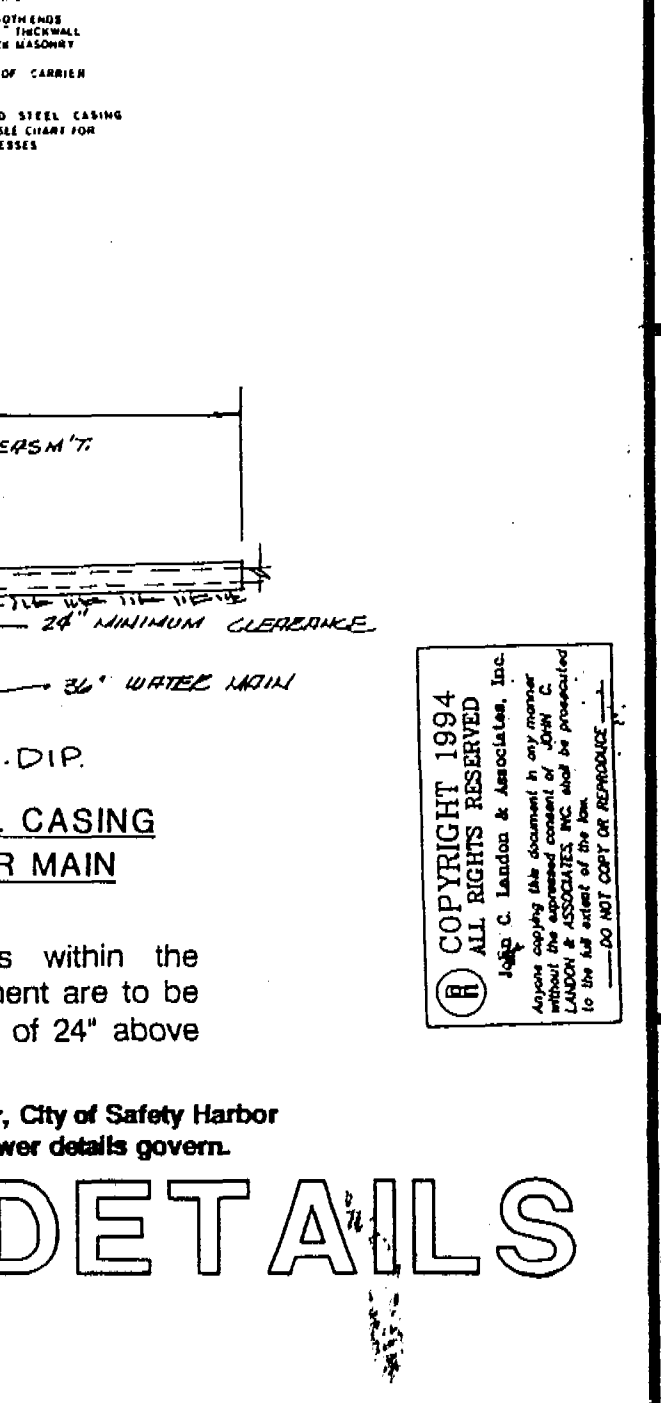
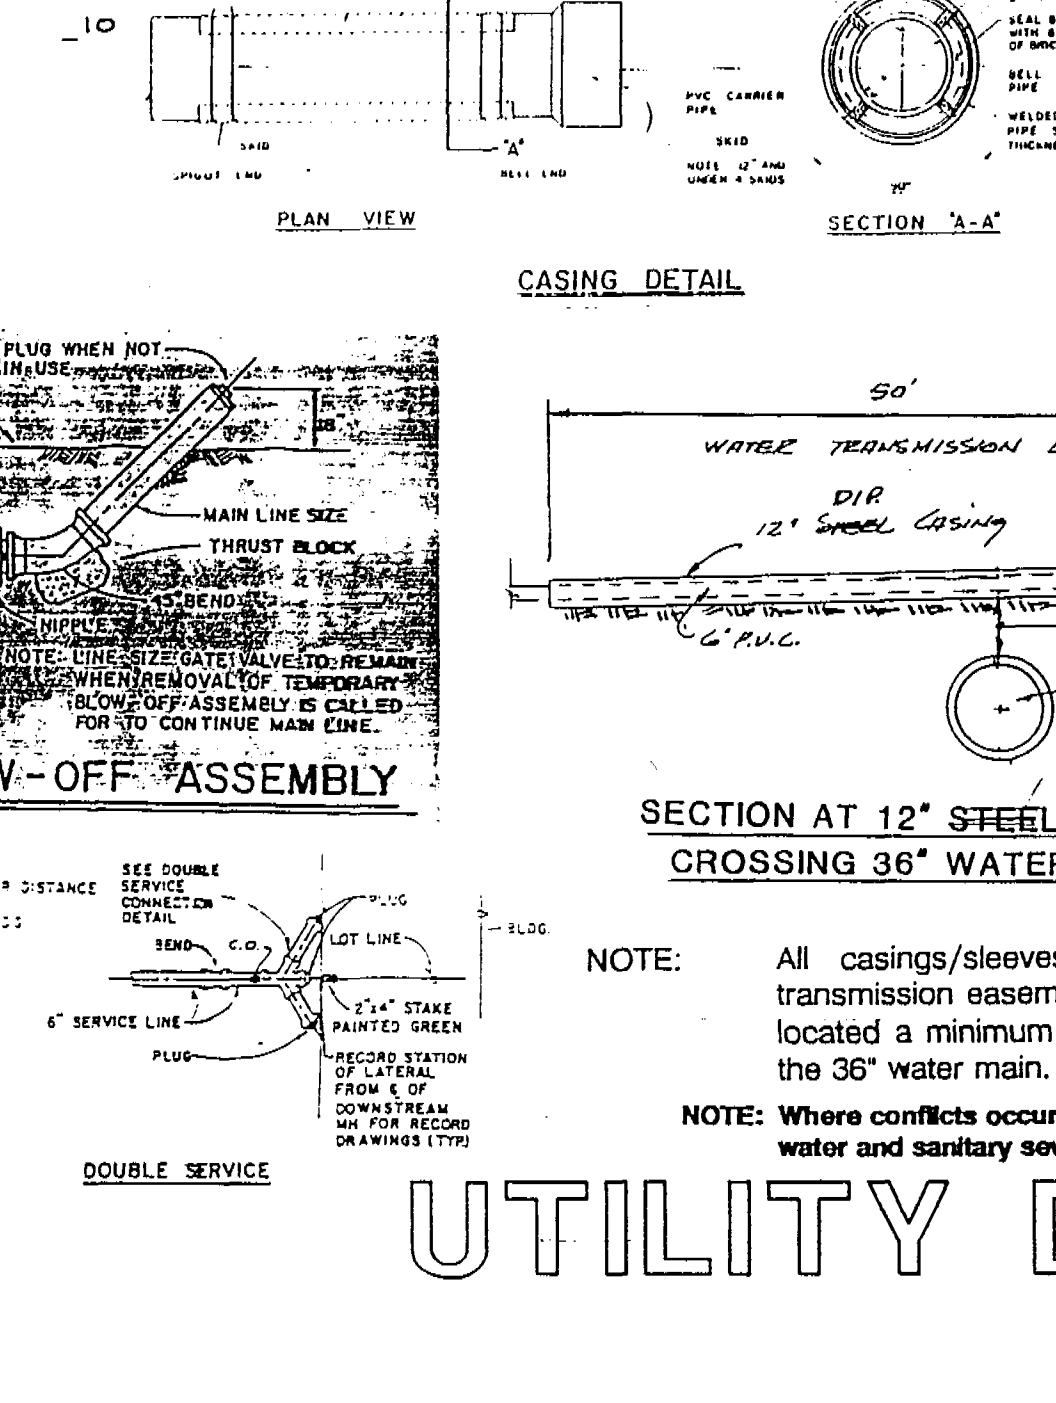
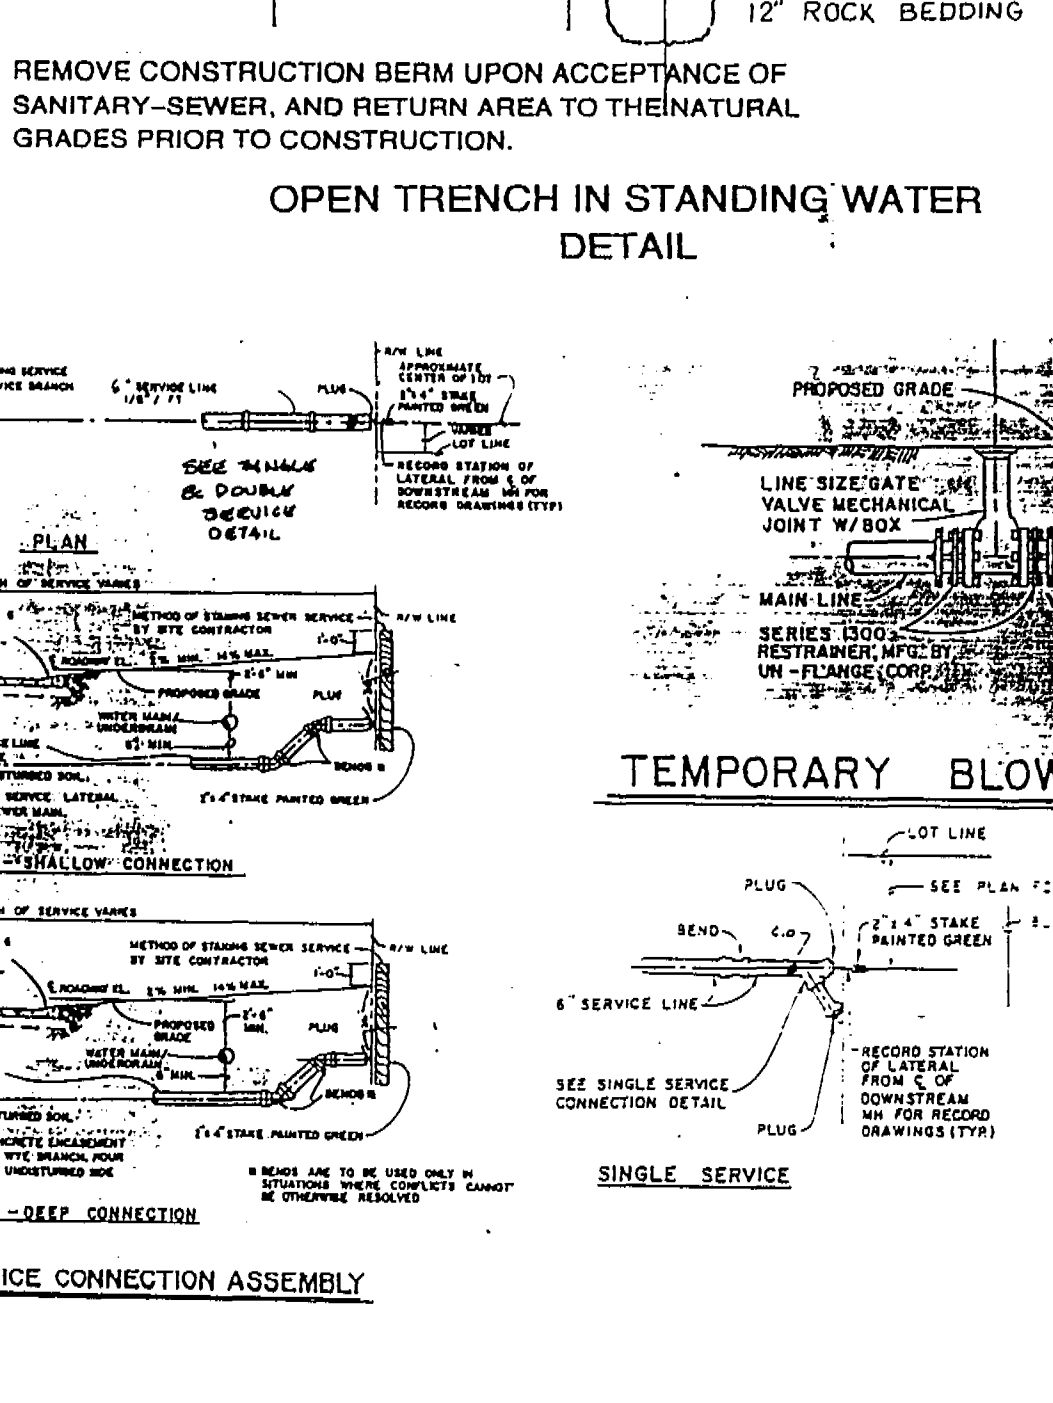
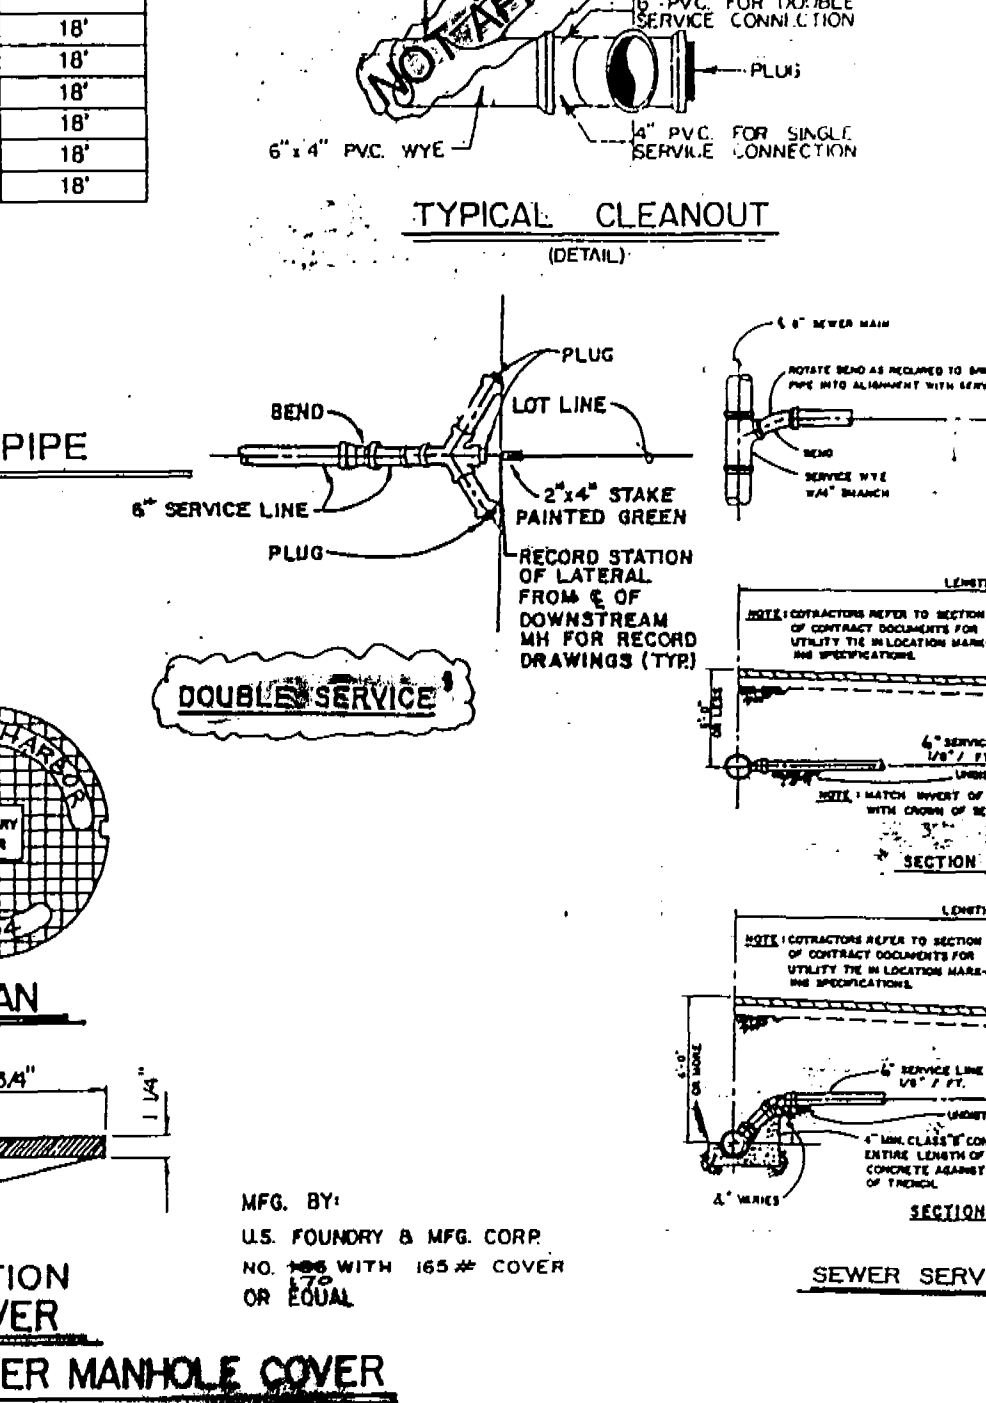
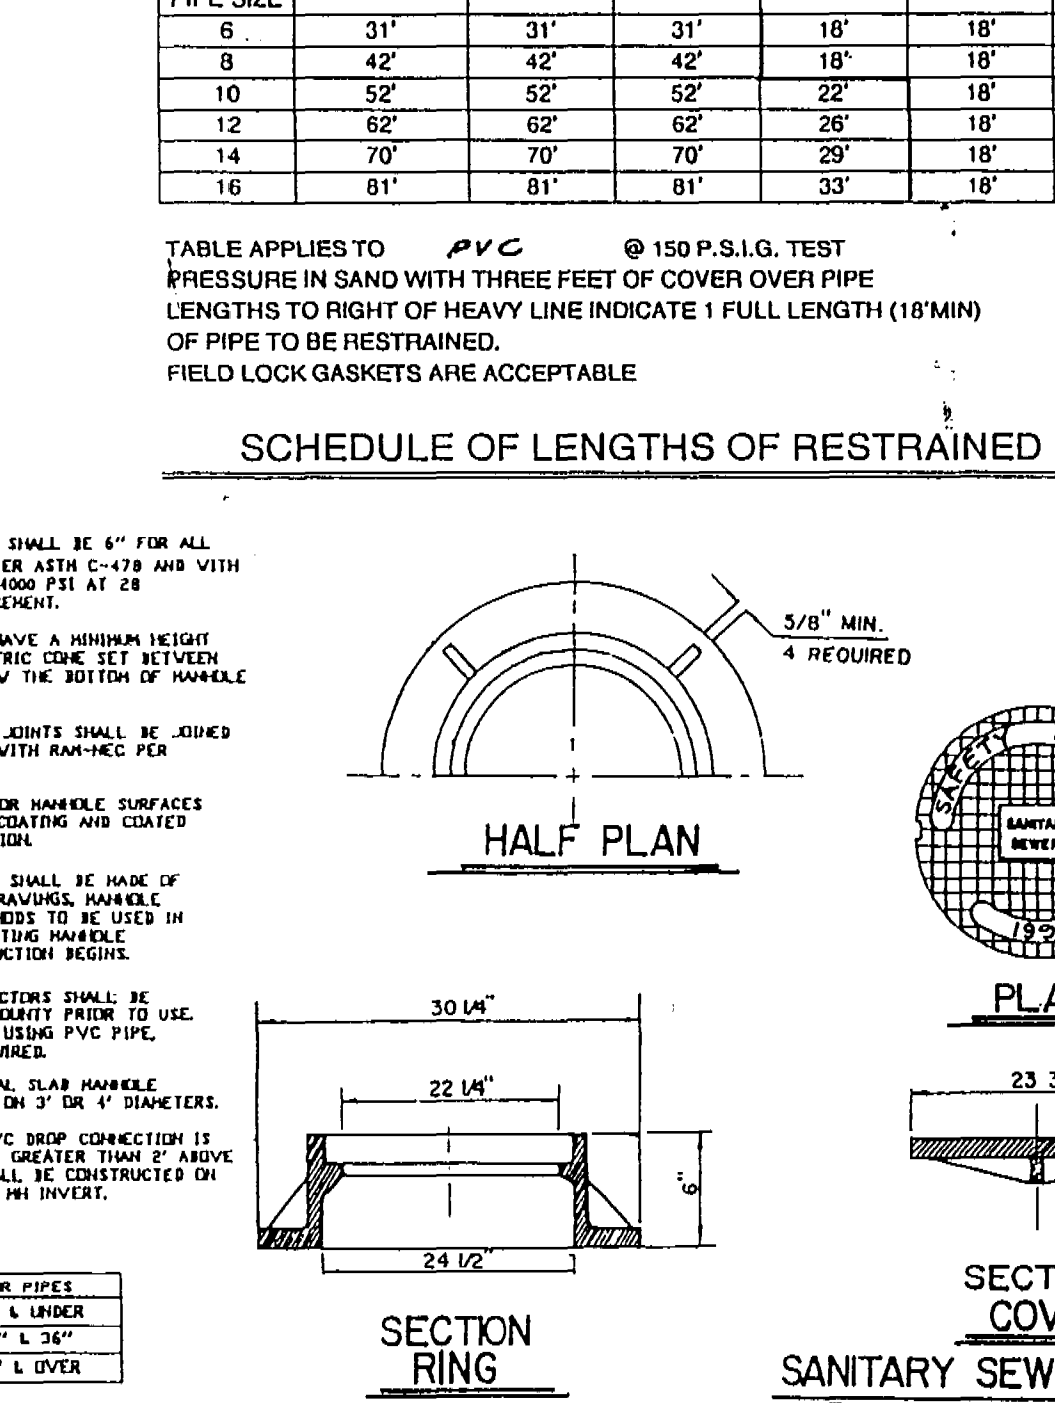
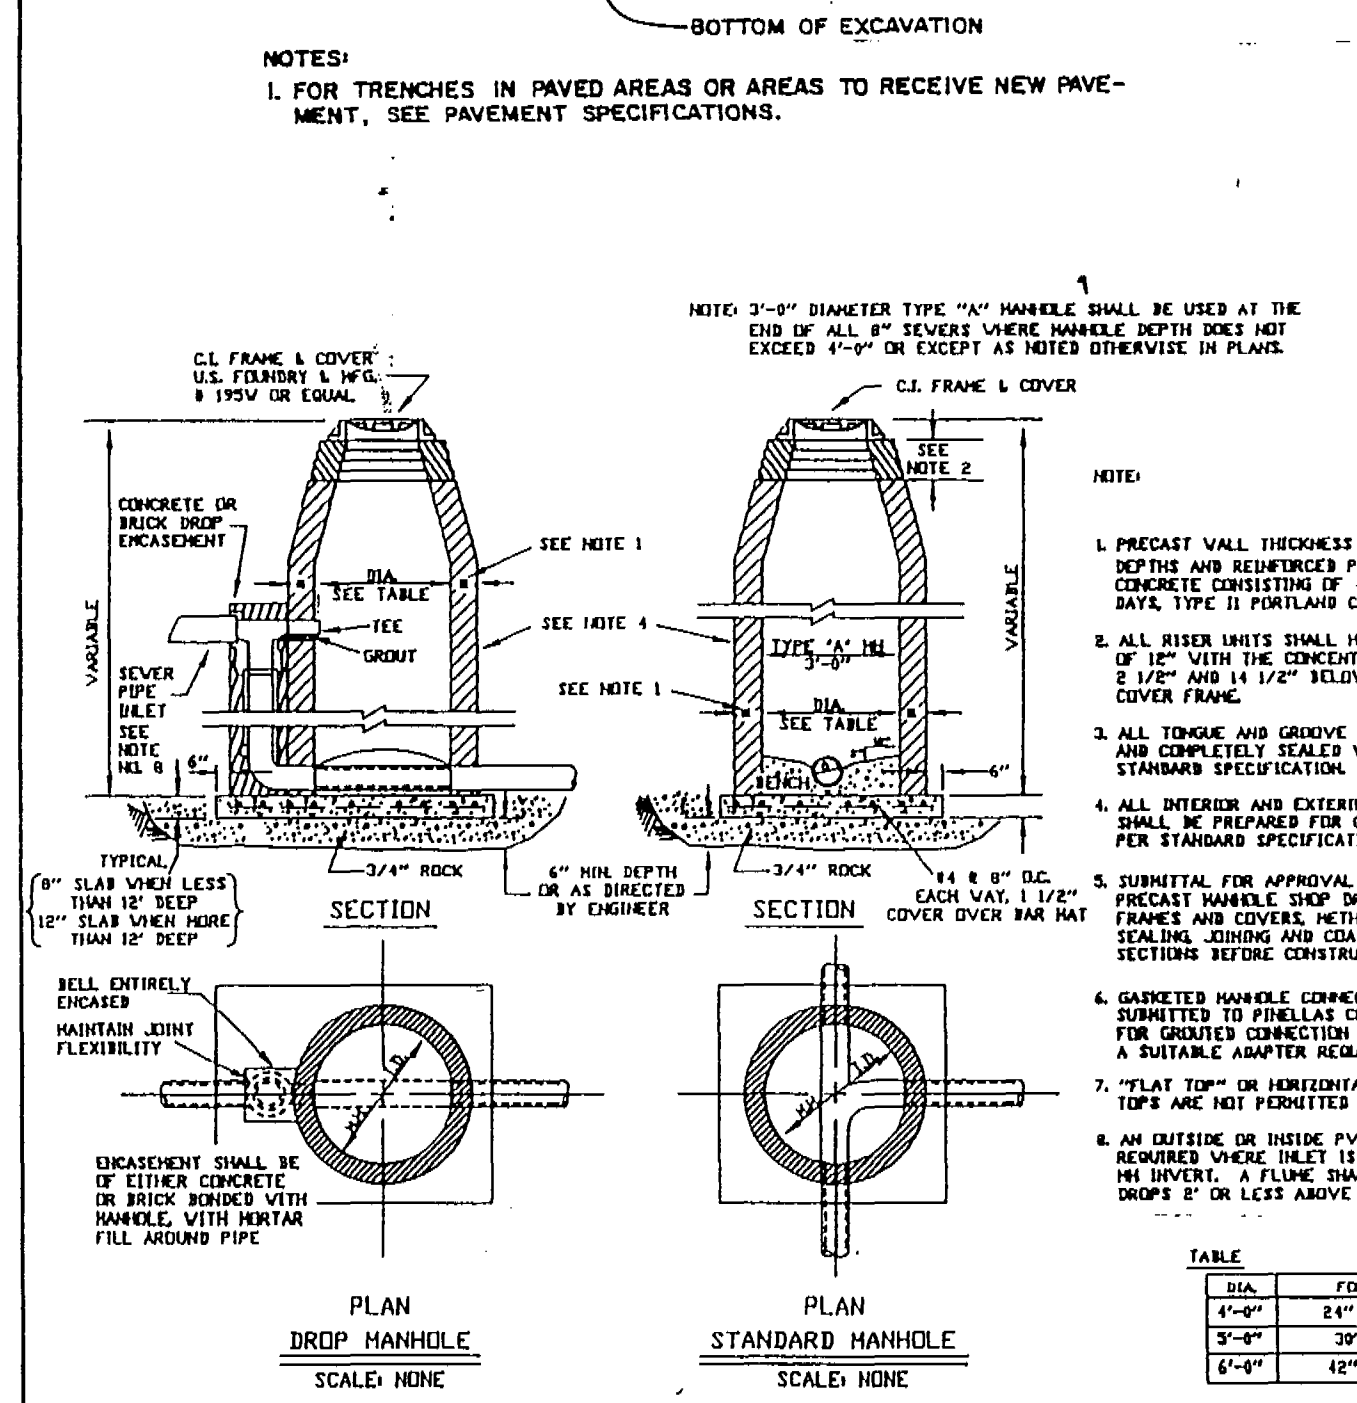
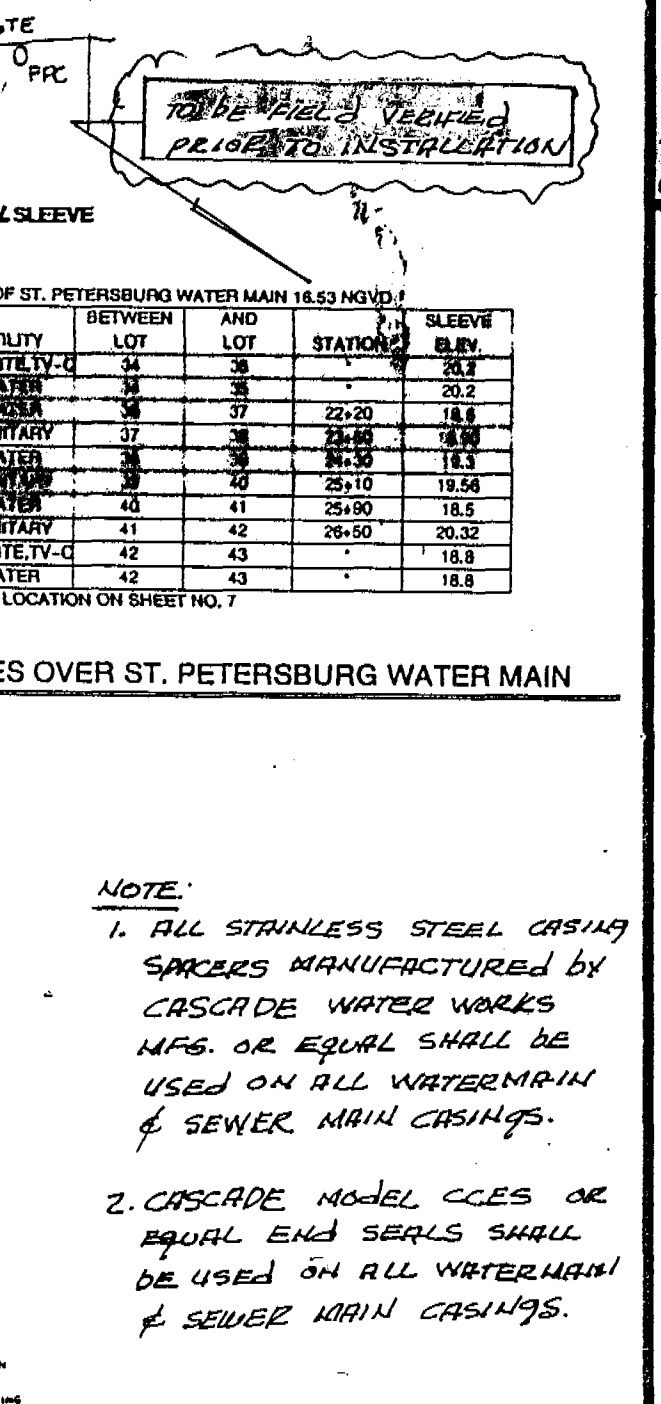
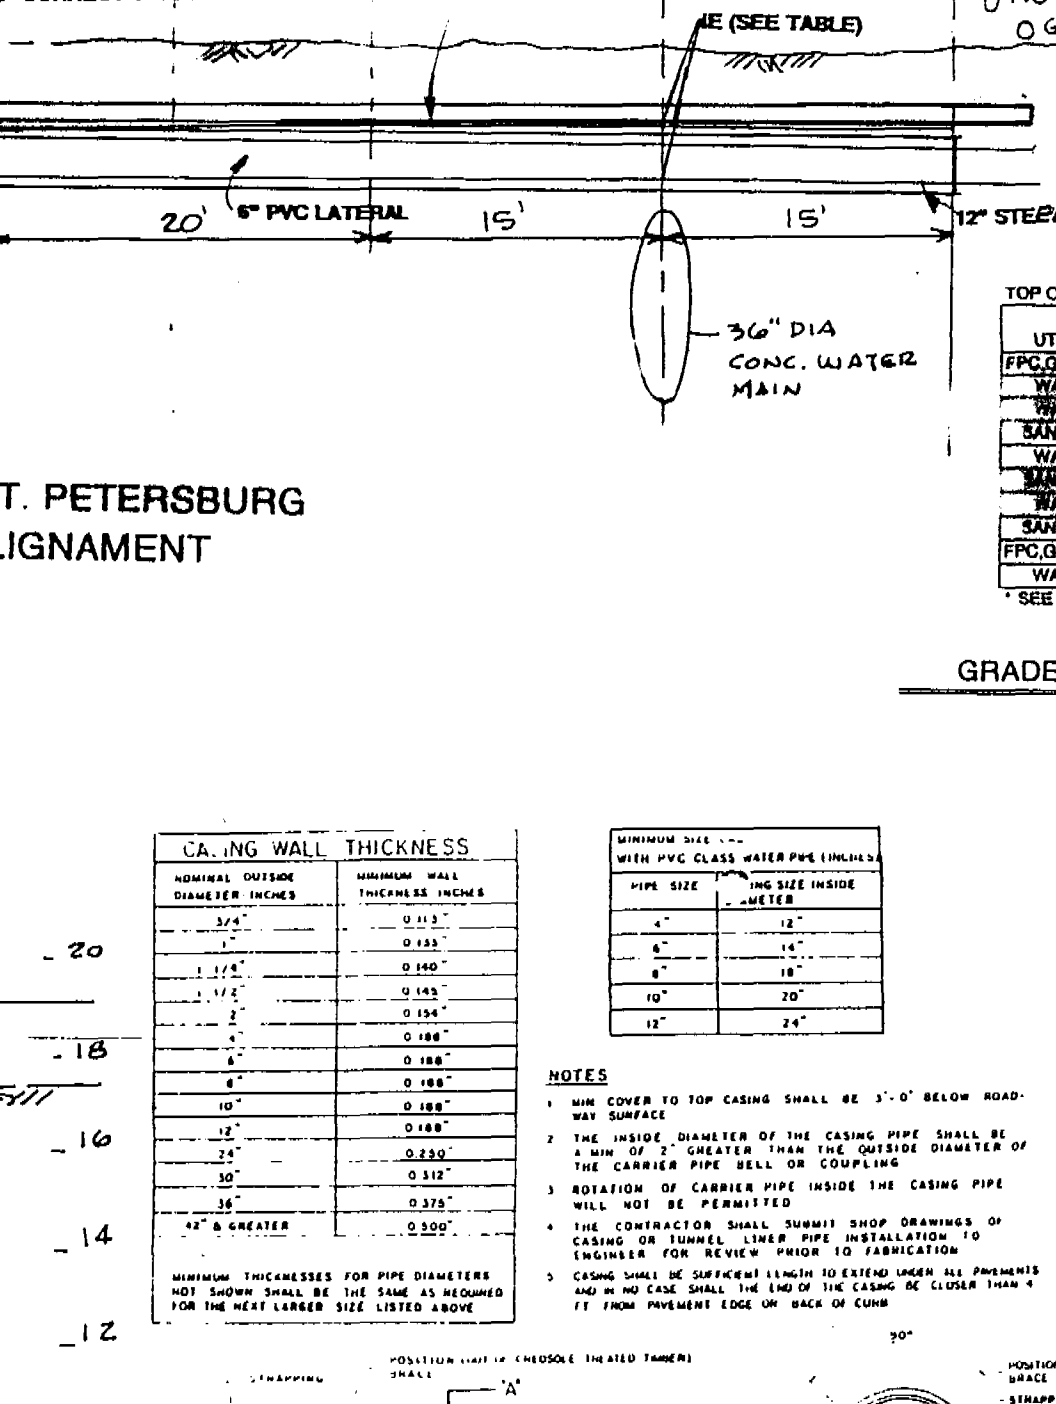
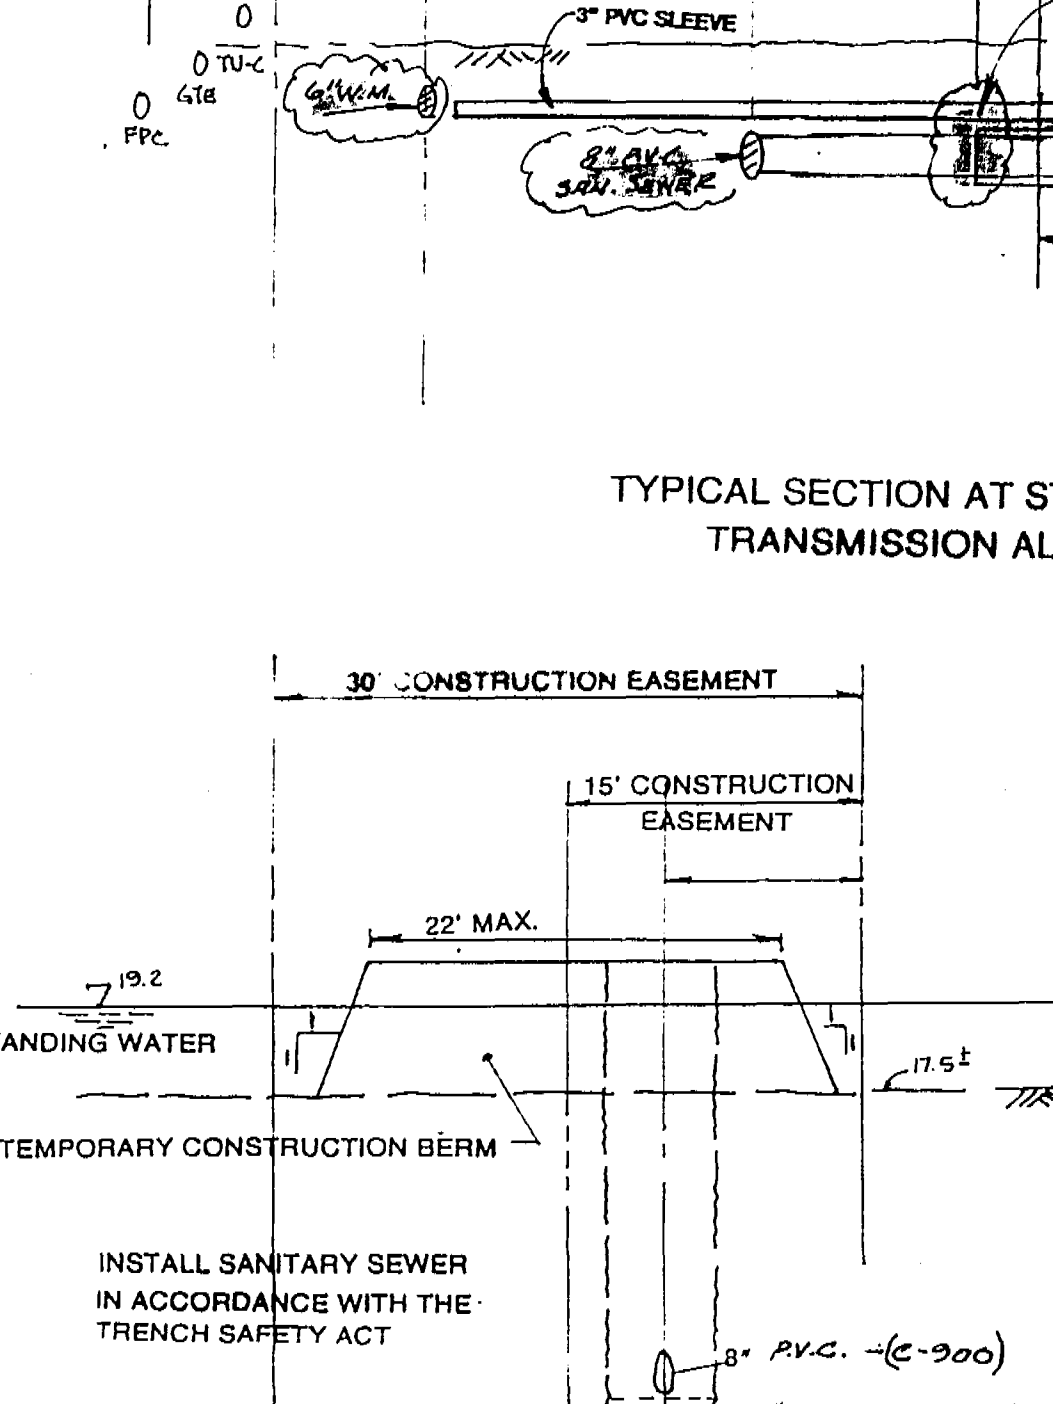
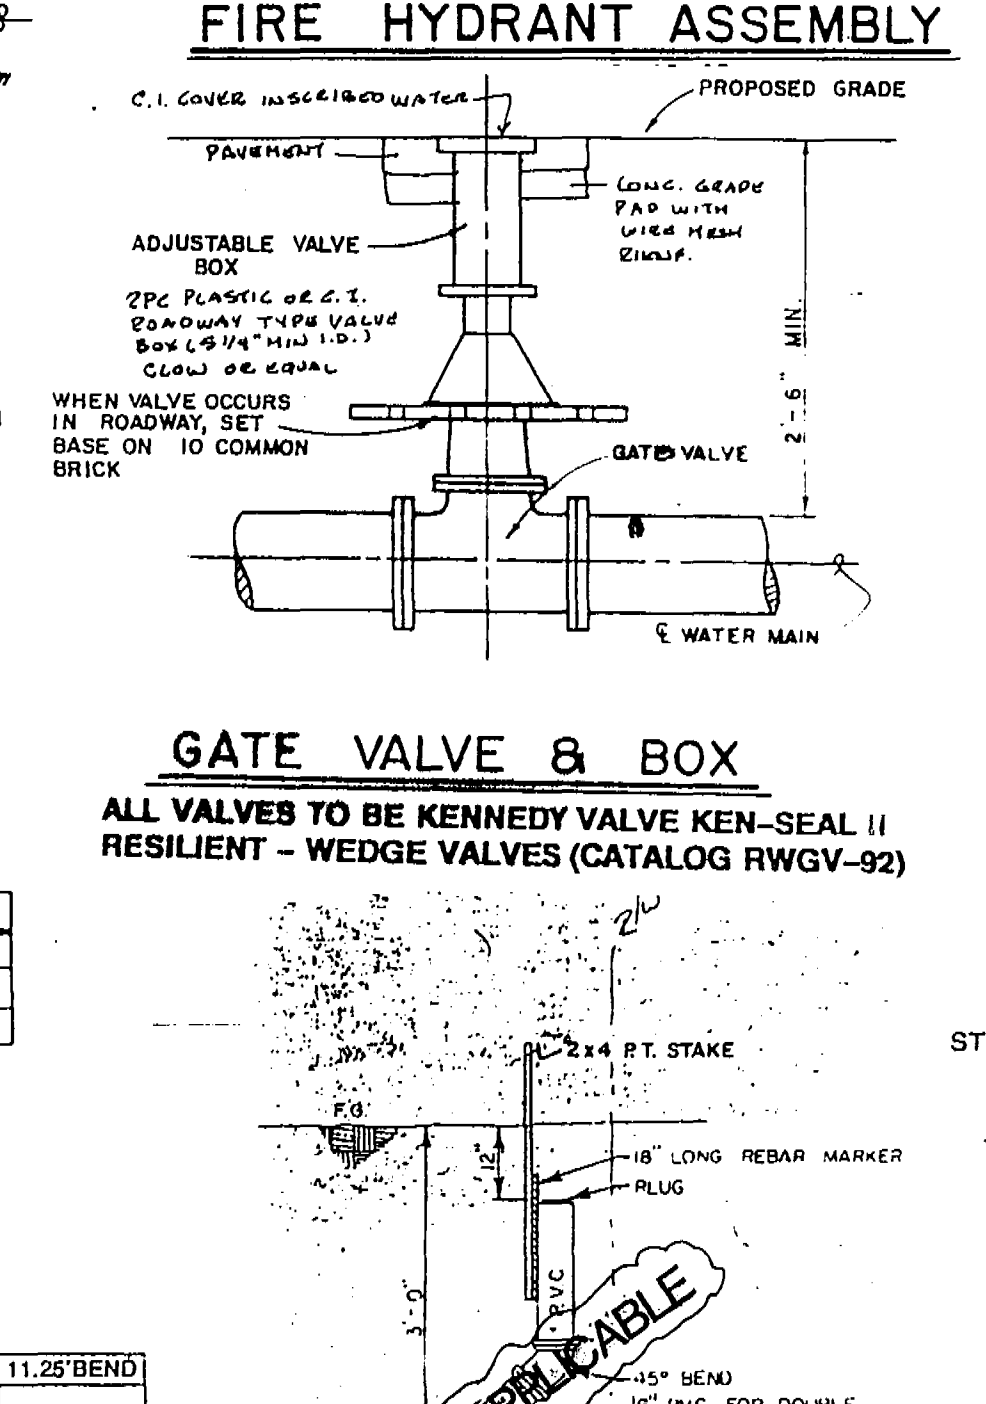
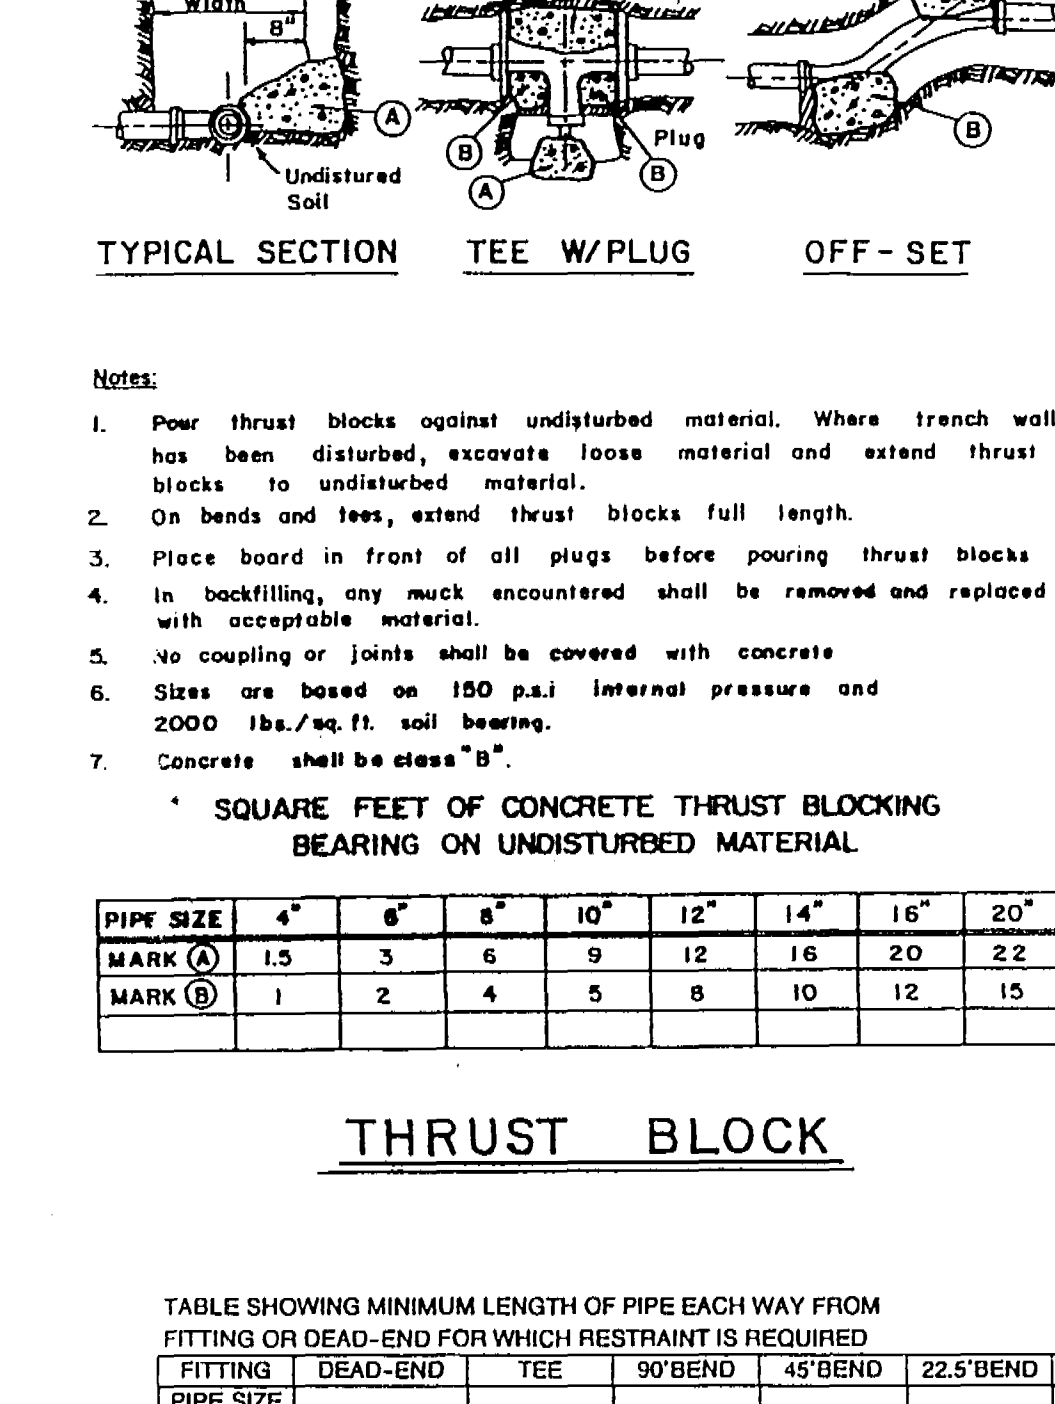
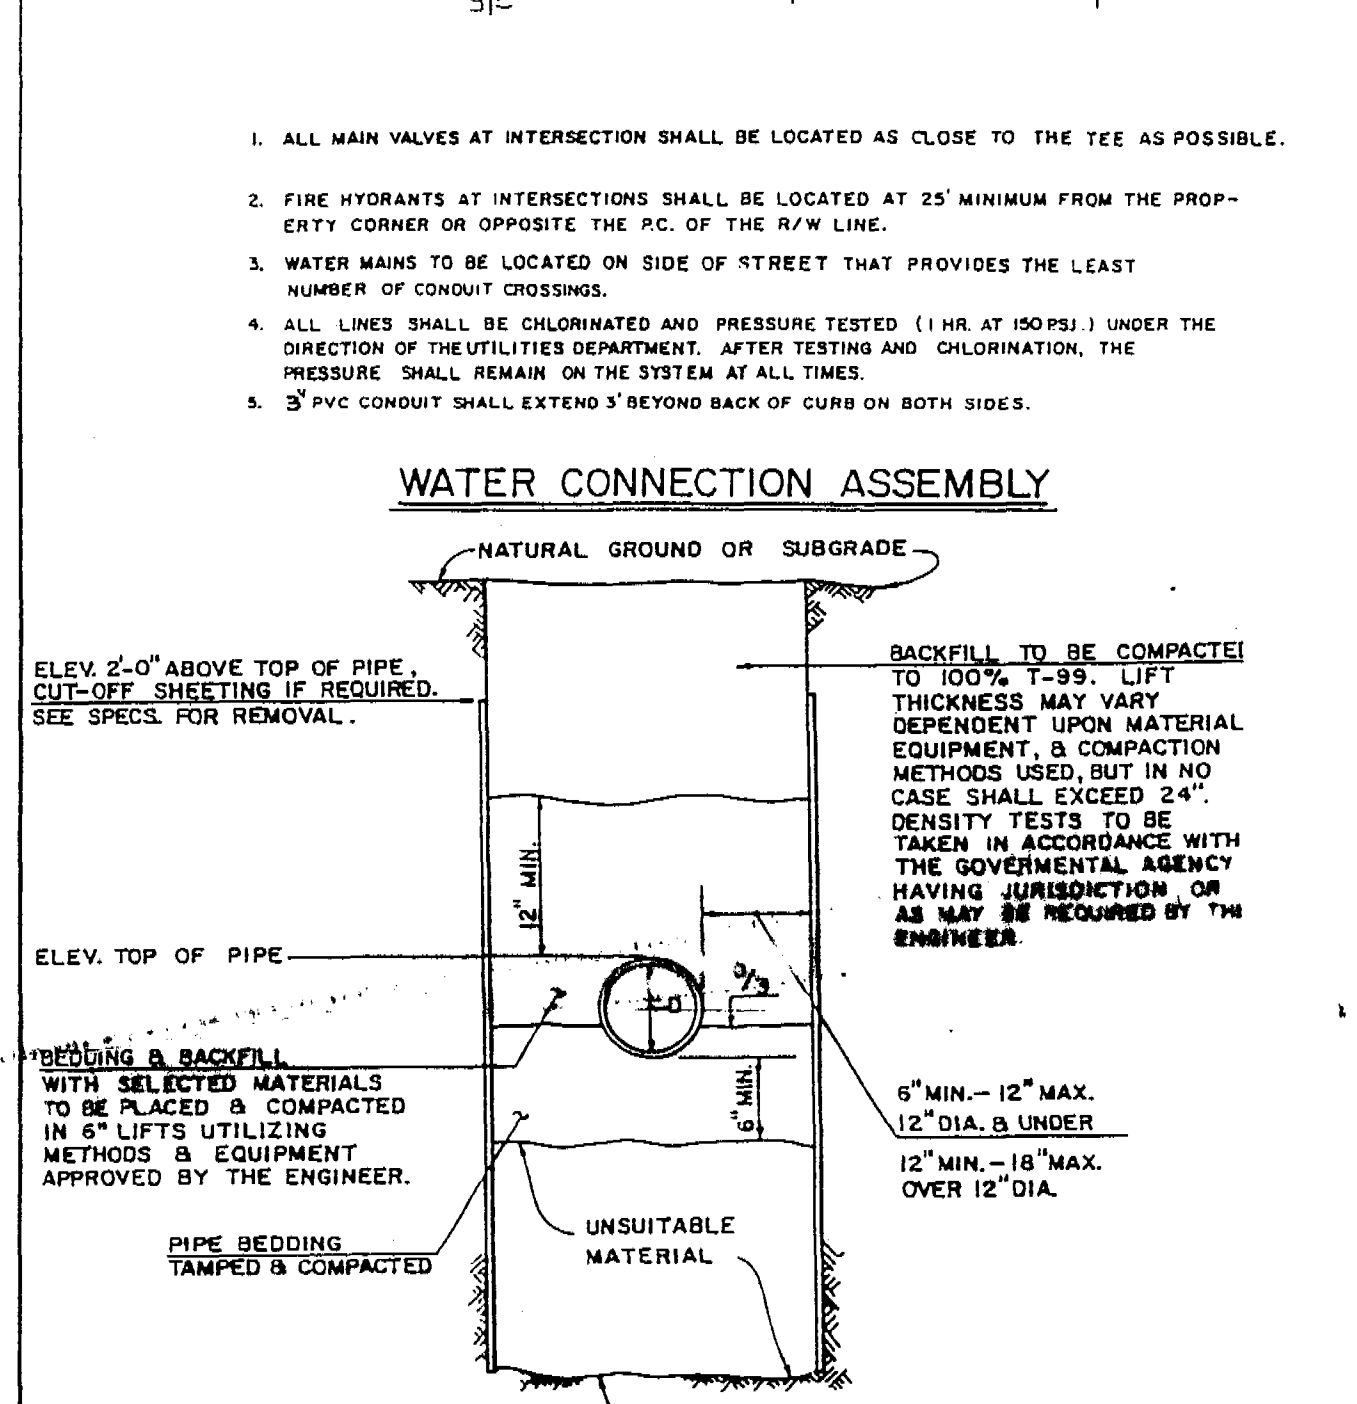
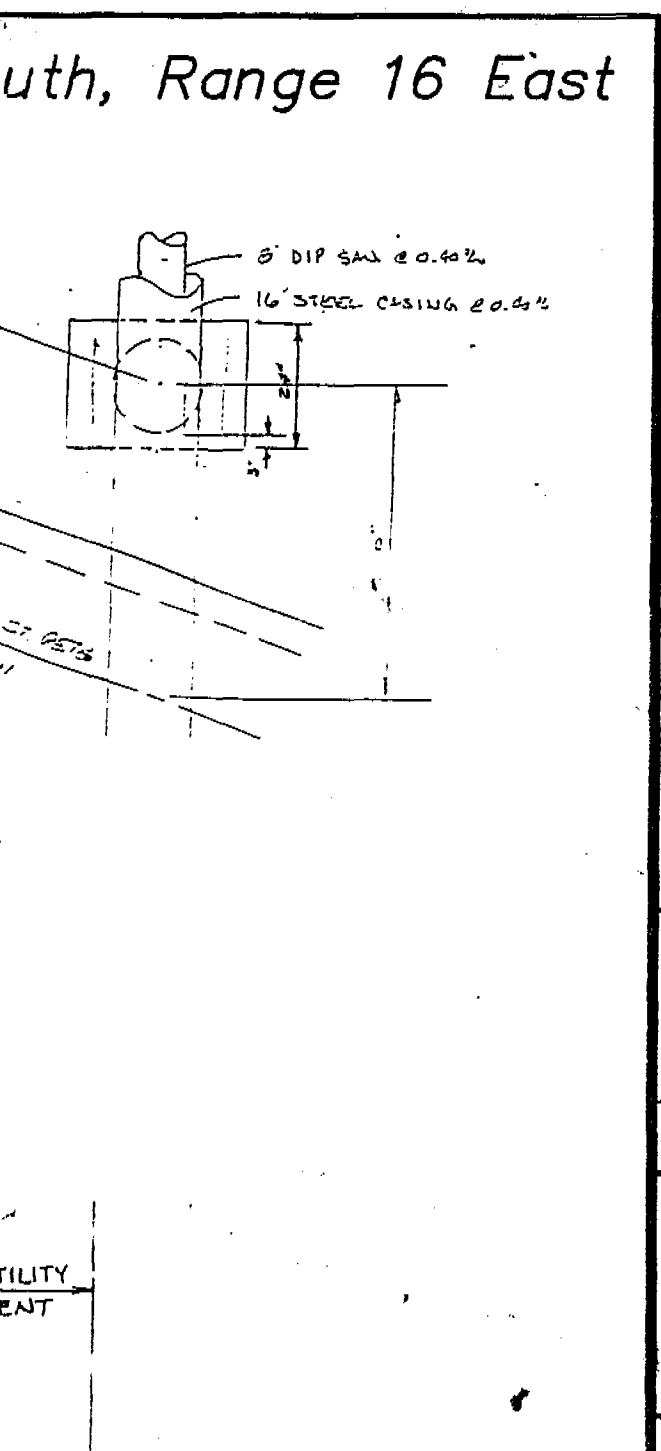
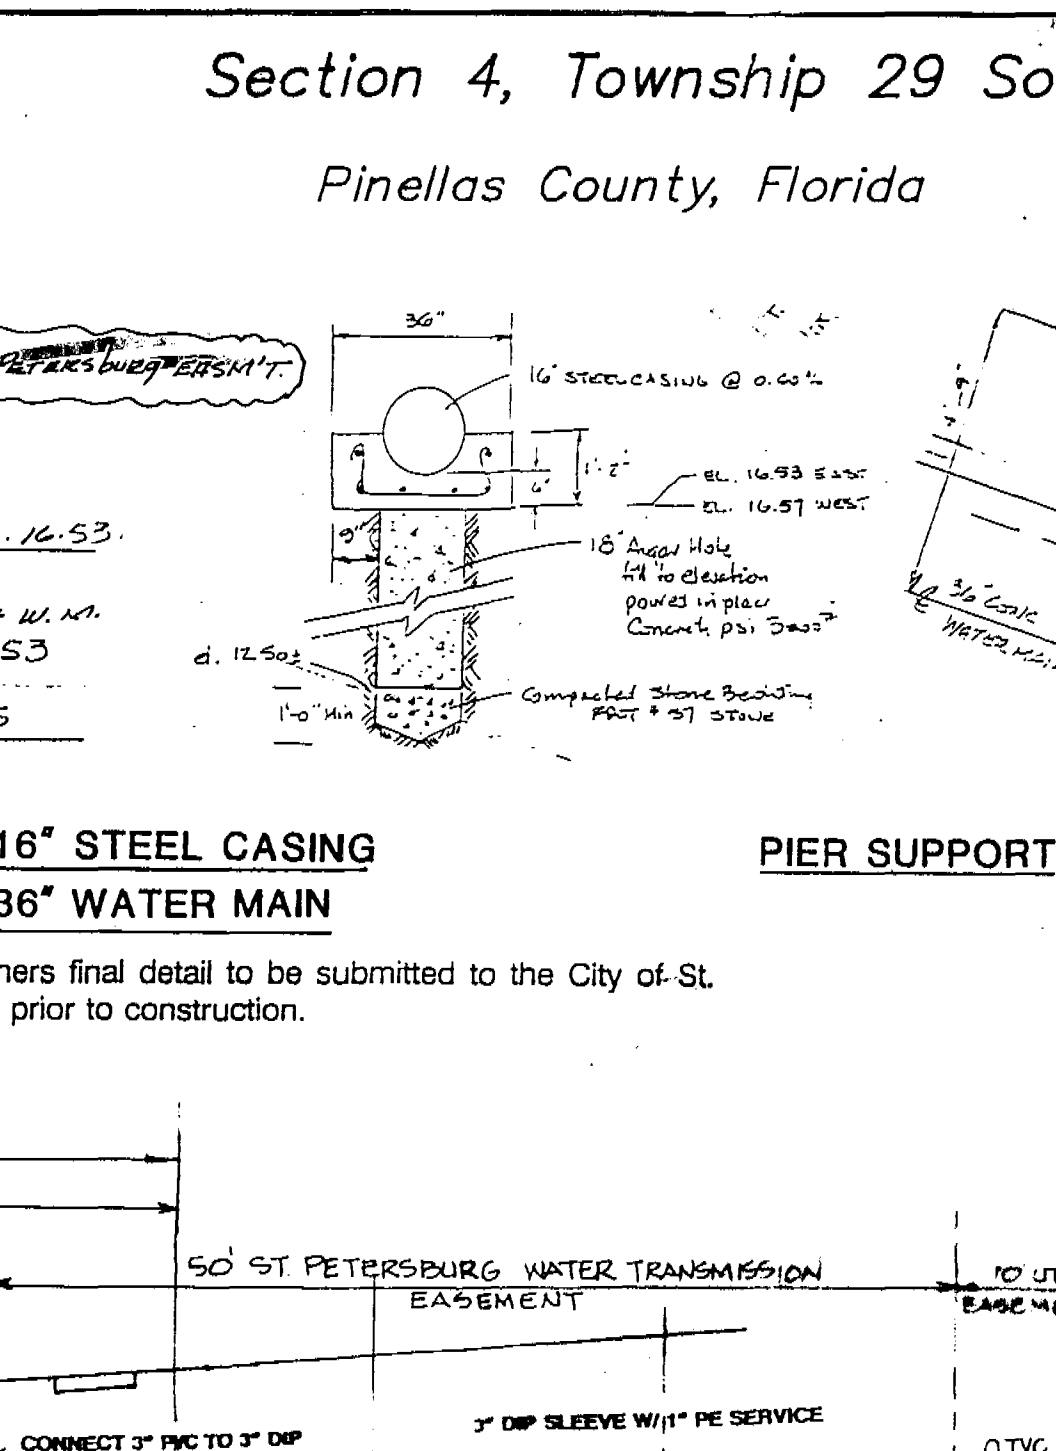
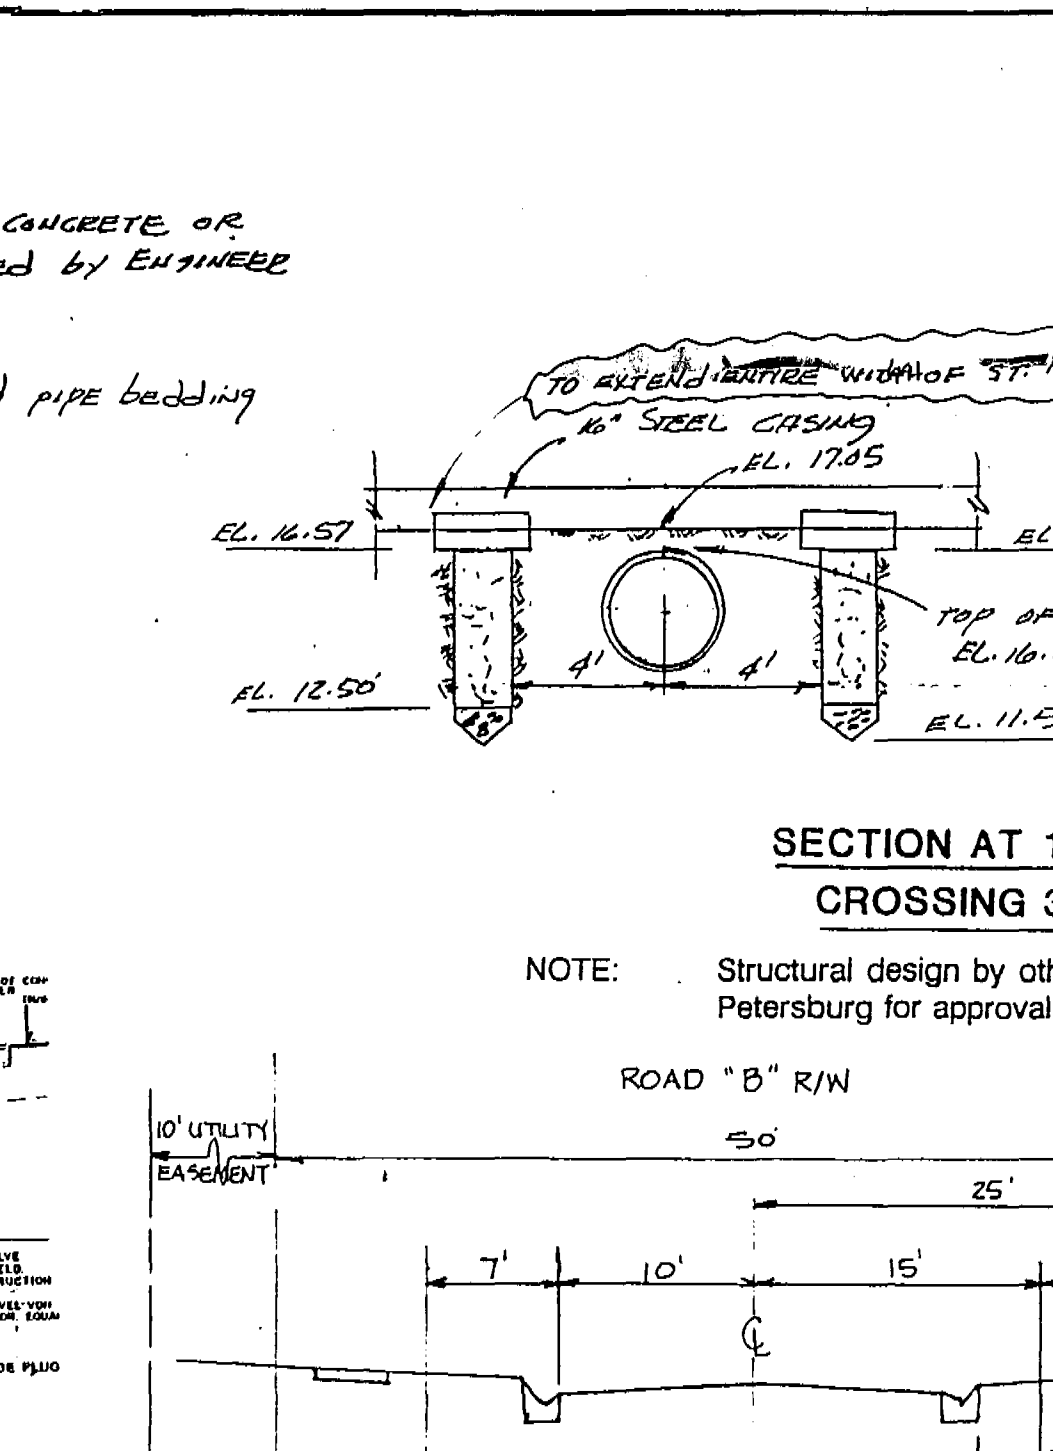
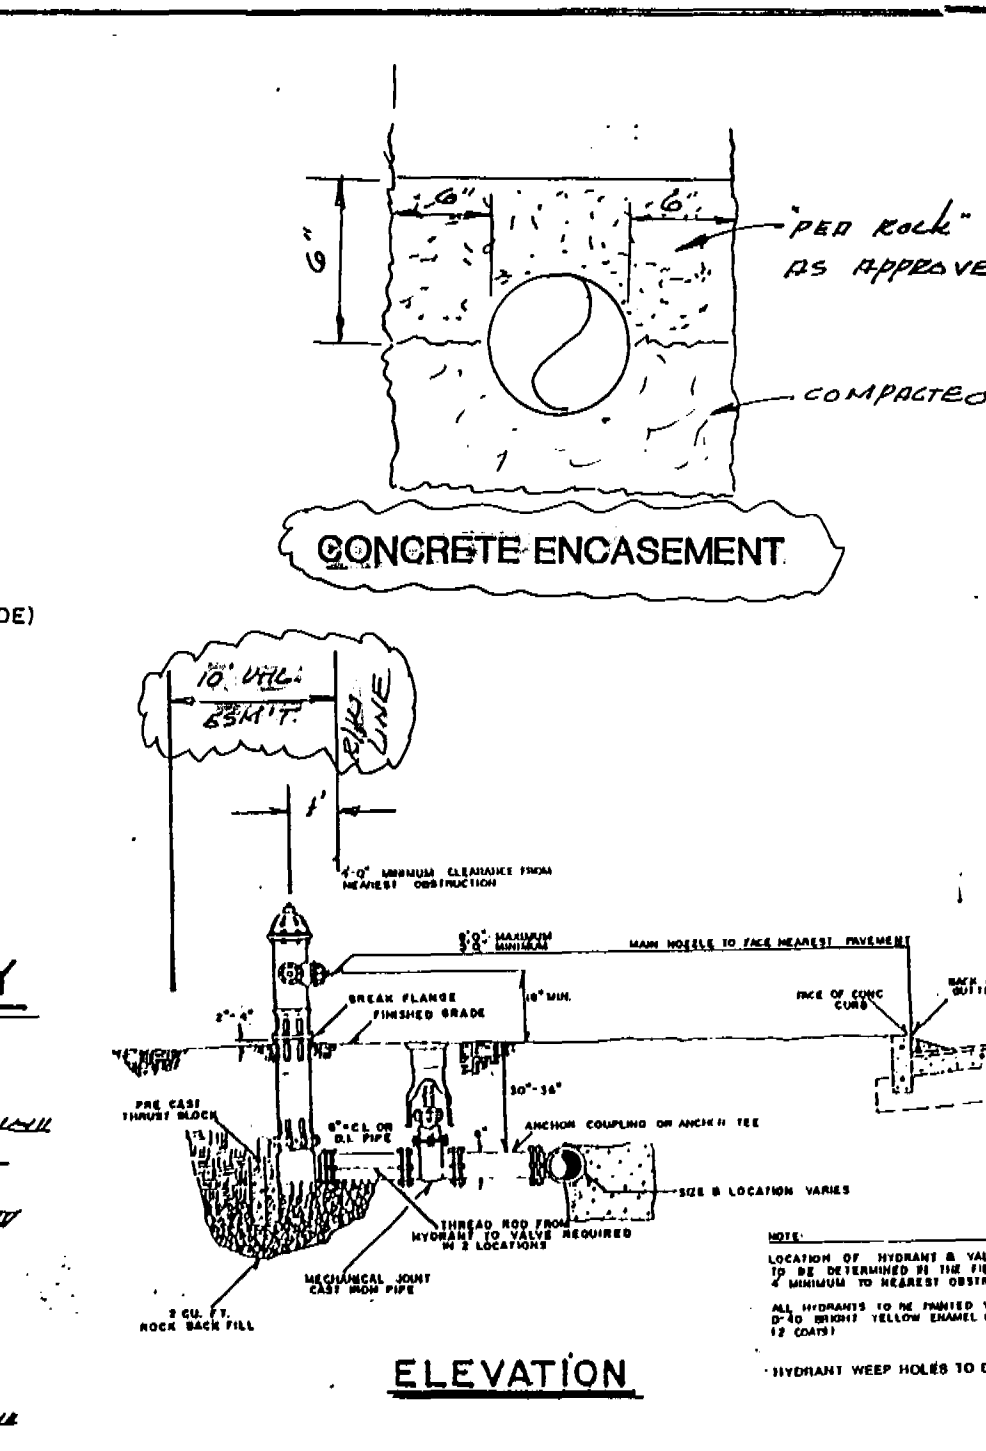
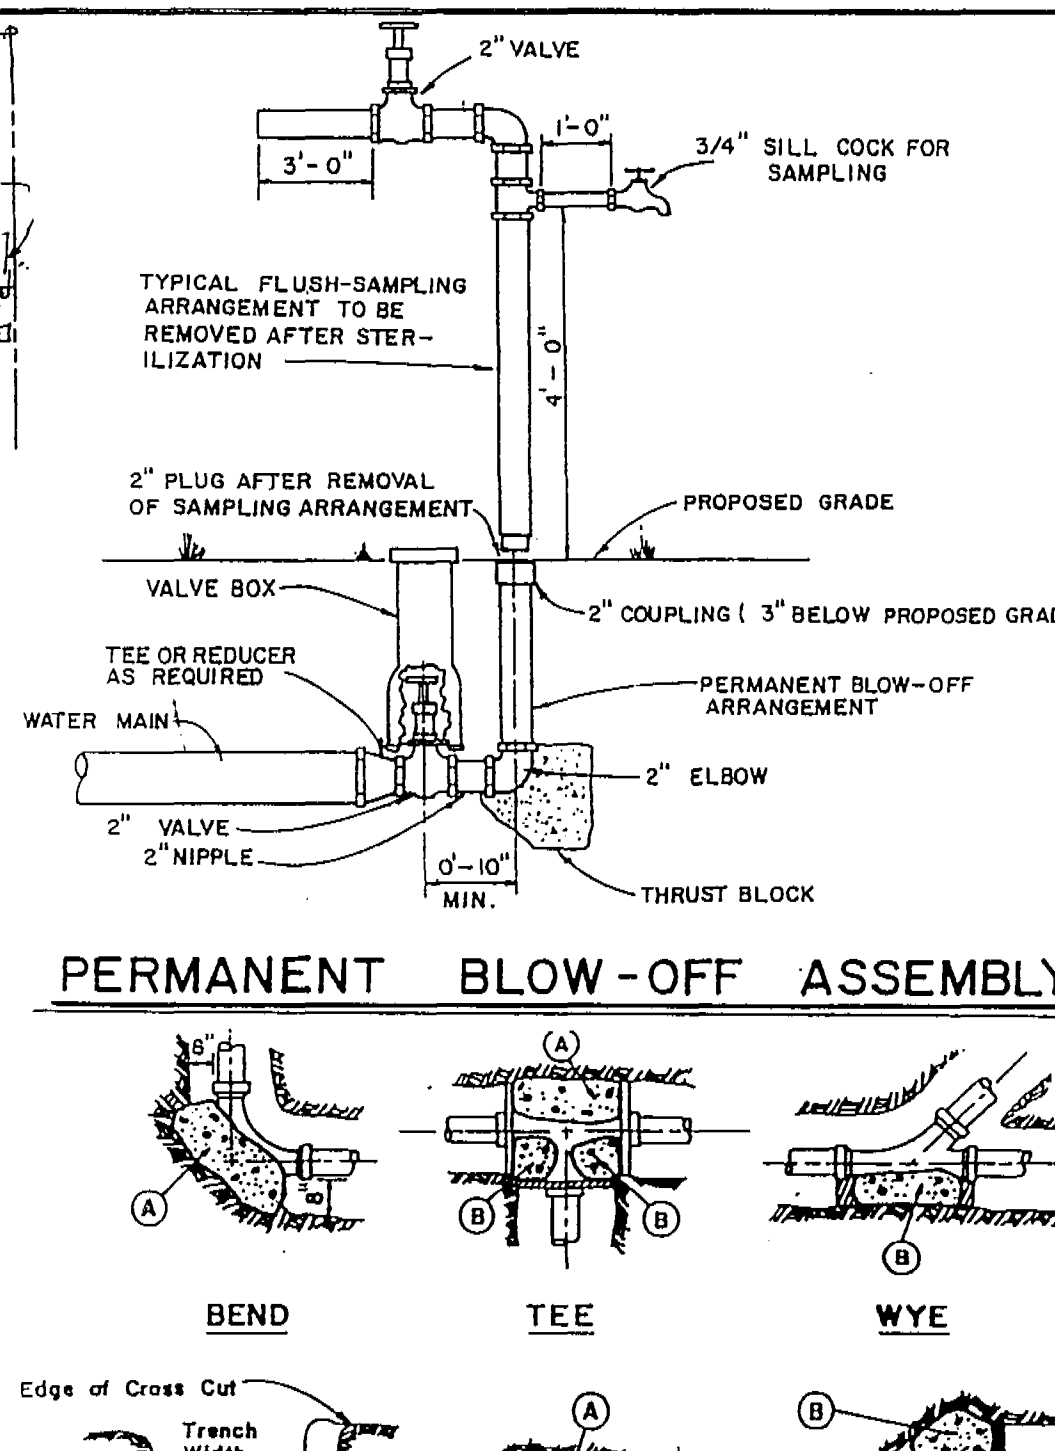


Section 4, Township 29 South, Range 16 East

Pinellas County, Florida

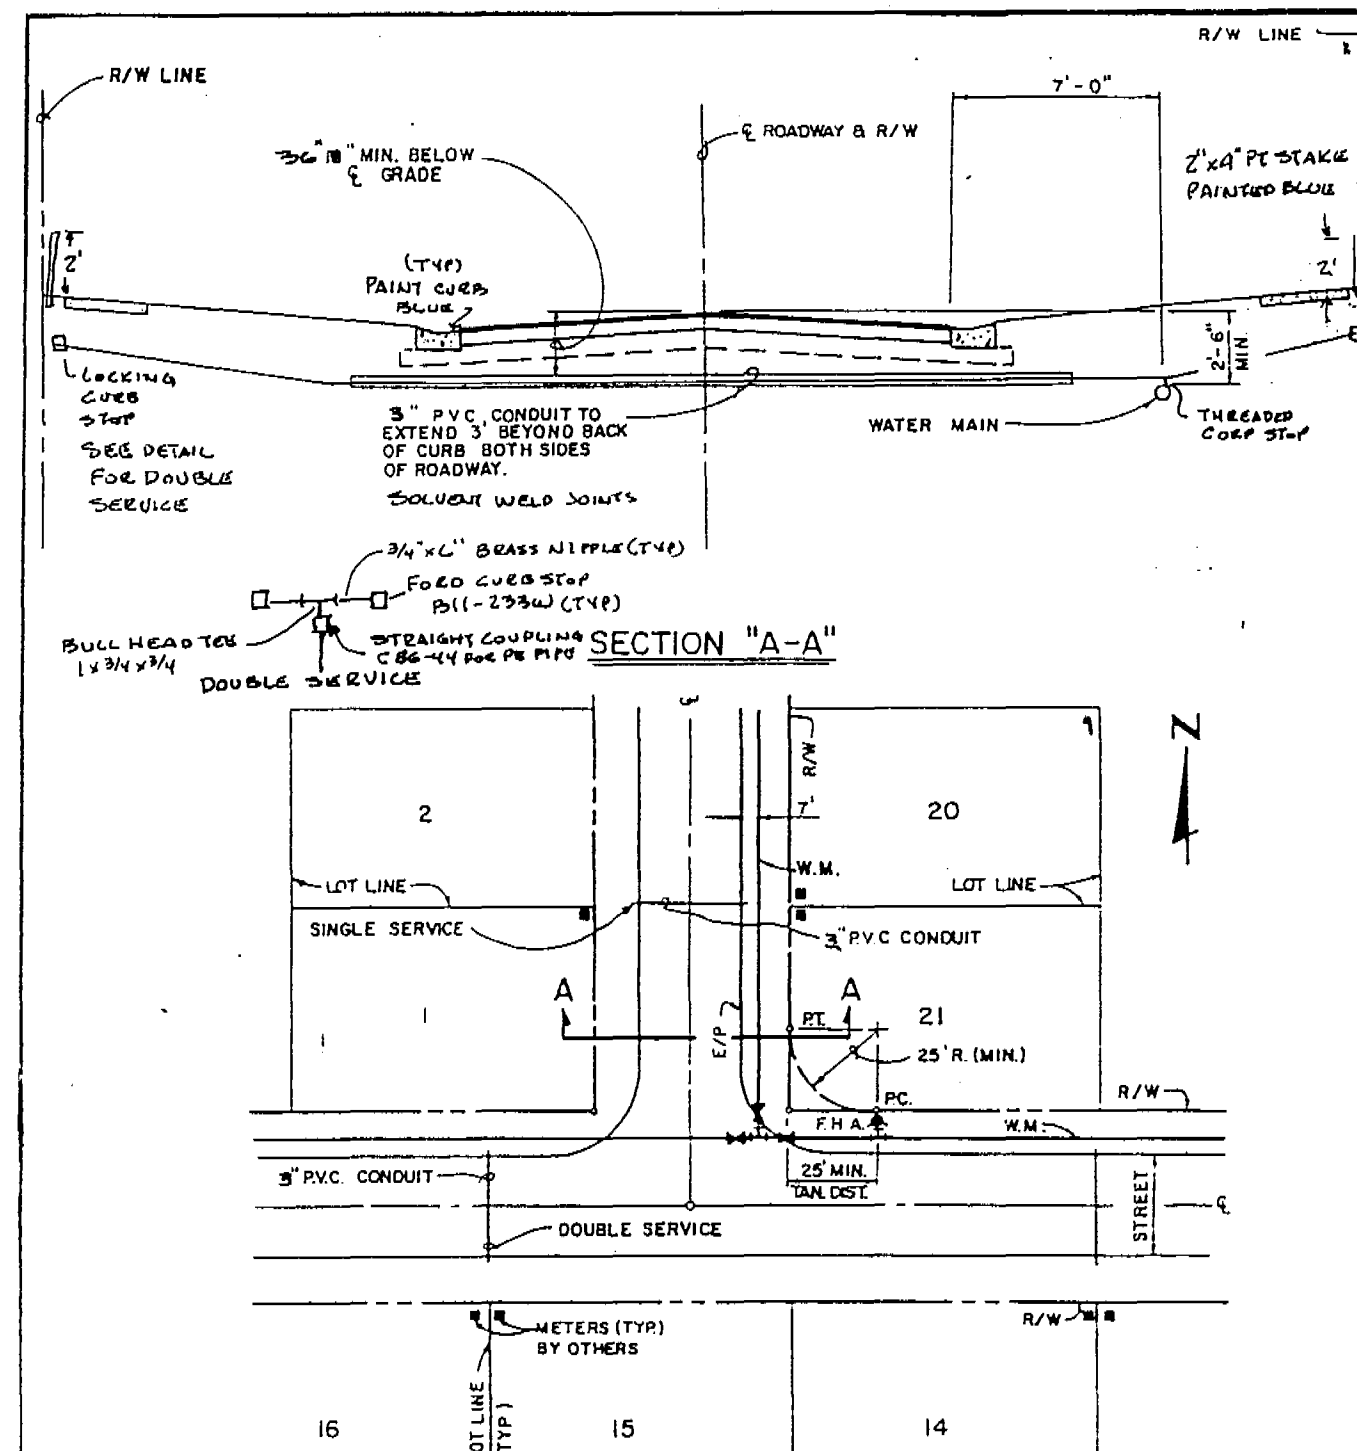

TOWERMARC CONSTRUCTION CORP.
1511 NORTH WESTSHORE BLVD.
TAMPA, FLORIDA 33607 (813) 287-8855

OLD HARBOR PLACE

JCLA
John C. London & Associates
CIVIL & ENVIRONMENTAL ENGINEERS
PLANNERS - SURVEYORS
1622 78th Ave S. Suite 200
Tampa, FL 33613 (813) 787-1394

UTILITY DETAILS

11
OF 15