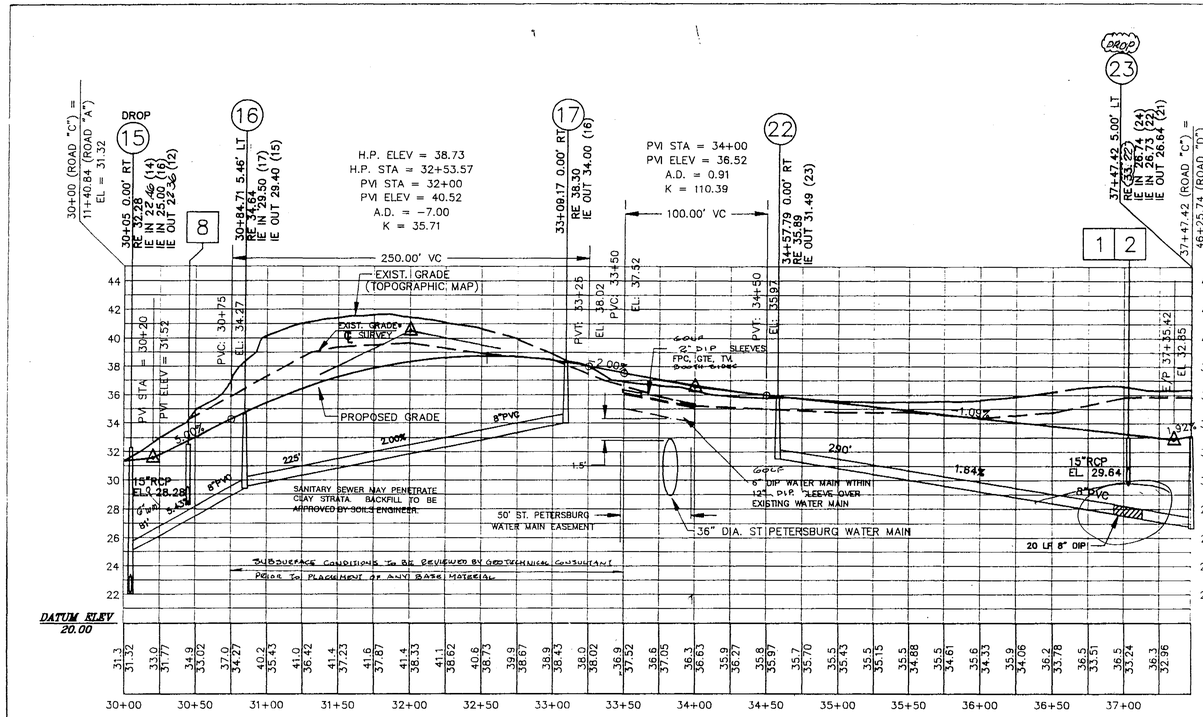

ROAD "C" **(HARBOR PLACE DRIVE)**

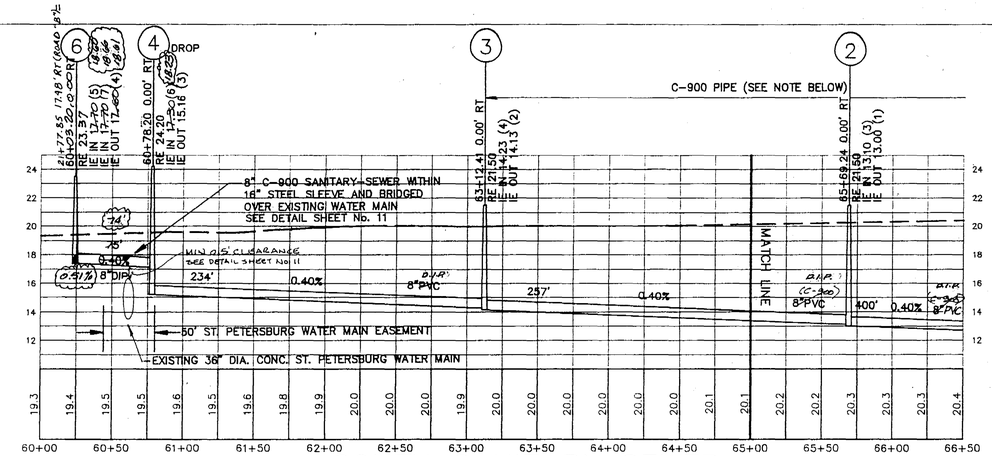

SOUTH SANITARY SEWER

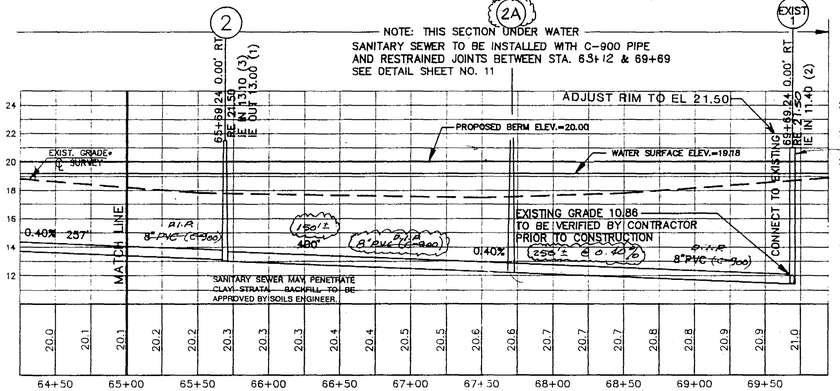

SOUTH SANITARY SEWER

EXISTING SANITARY SEWER IS OFF-SITE WITHIN EASEMENT. LOCATE EASEMENT IN FIELD PRIOR TO CONSTRUCTION.

NOTE: * ℄ SURVEY OF EXISTING GROUND BASED ON CURRENT SURVEY DATUM DEVIATIONS FROM TOPOGRAPHIC MAP SHALL BE NOTED BY CONTRACTOR DURING CONSTRUCTIONS. MAJOR ADJUSTMENT WHERE PROPOSED GRADE MEETS EXISTING GRADE SHALL BE BROUGHT TO THE ATTENTION OF THE DESIGN ENGINEER.

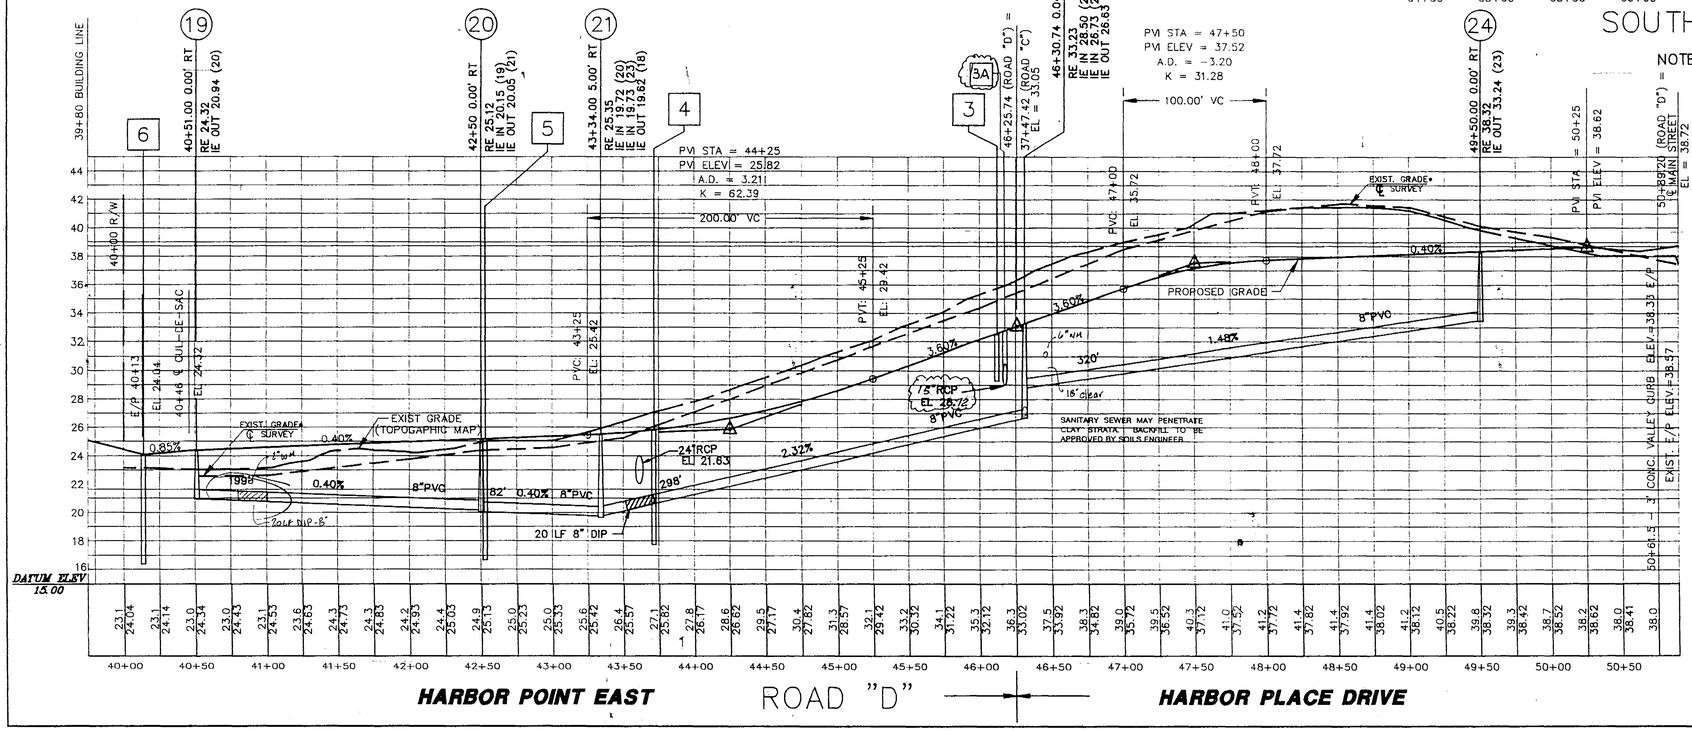

HARBOR POINT EAST ROAD "D" **HARBOR PLACE DRIVE**

SCALE:
1" = 50' HORIZ.
1" = 5' VERT.

PROFILES

REVISIONS	
06-01-94	REVISED FOR CITY SUBMITTAL
08-01-94	PER CONSTRUCTION COMMENTS
9.12.94	PER SOUTHWEST CONTRACTORS of 9.6.94
10-17-96	REVISED PER CITY OF ST. PETERSBURG COMMENTS
10-18-96	PER MCS - BELOW WATER CROSSING SANITARY
11-22-96	TO ISSUE FOR CONSTRUCTION

Design: WCK
Drawn: JWR
Scale: 1"=50'
Date: 03-14-94
Checked:
Job No: 214-01
F:\DWGS\214-01\PROFILE.DWG

OLD HARBOR PLACE

TOWERMARC CONSTRUCTION CORP.
1511 NORTH WESTSHORE BLVD.
TAMPA, FLORIDA 33607 (813) 287-8255

JCLA
John C. Landon & Associates
CIVIL & ENVIRONMENTAL ENGINEERS
PLANNERS - SURVEYORS
3162E Ulmerton Road Clearwater, Florida 34684
PHONE (813) 576-5510 FAX (813) 797-4394